
T. 2N. R. 31&32E. W.M.

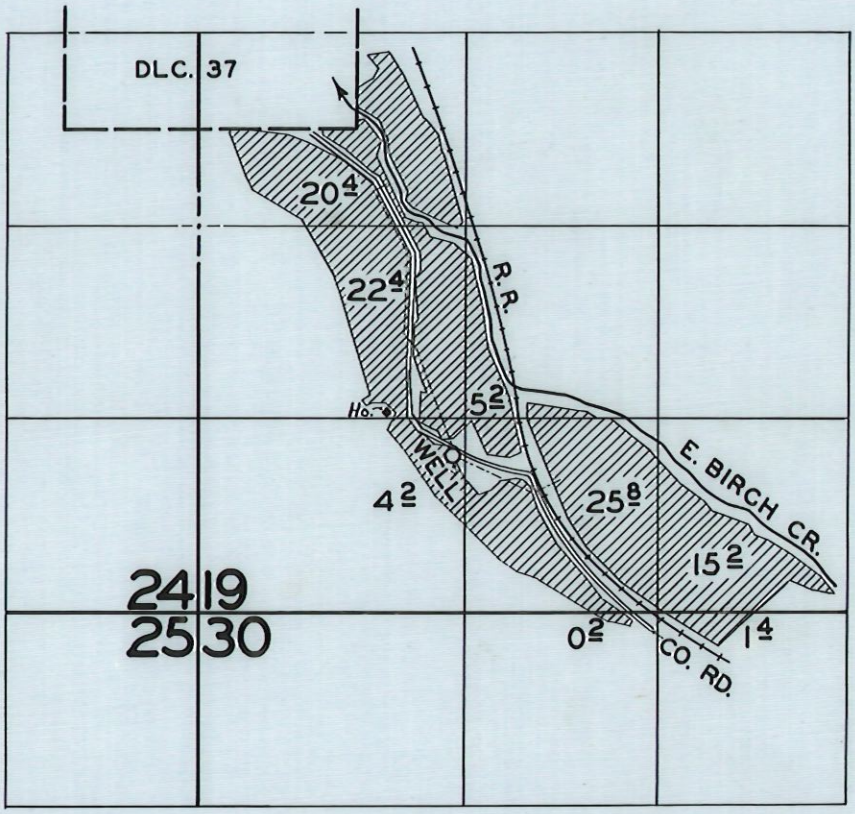

FINAL PROOF SURVEY

UNDER

Application No. U-356 Permit No. U-325

IN NAME OF

MILTON H. CARTER

Surveyed MAY 15 1957, by C.O. Bartels

1957 Z