


Township 345 Range 3W

Township 345 Range 2W

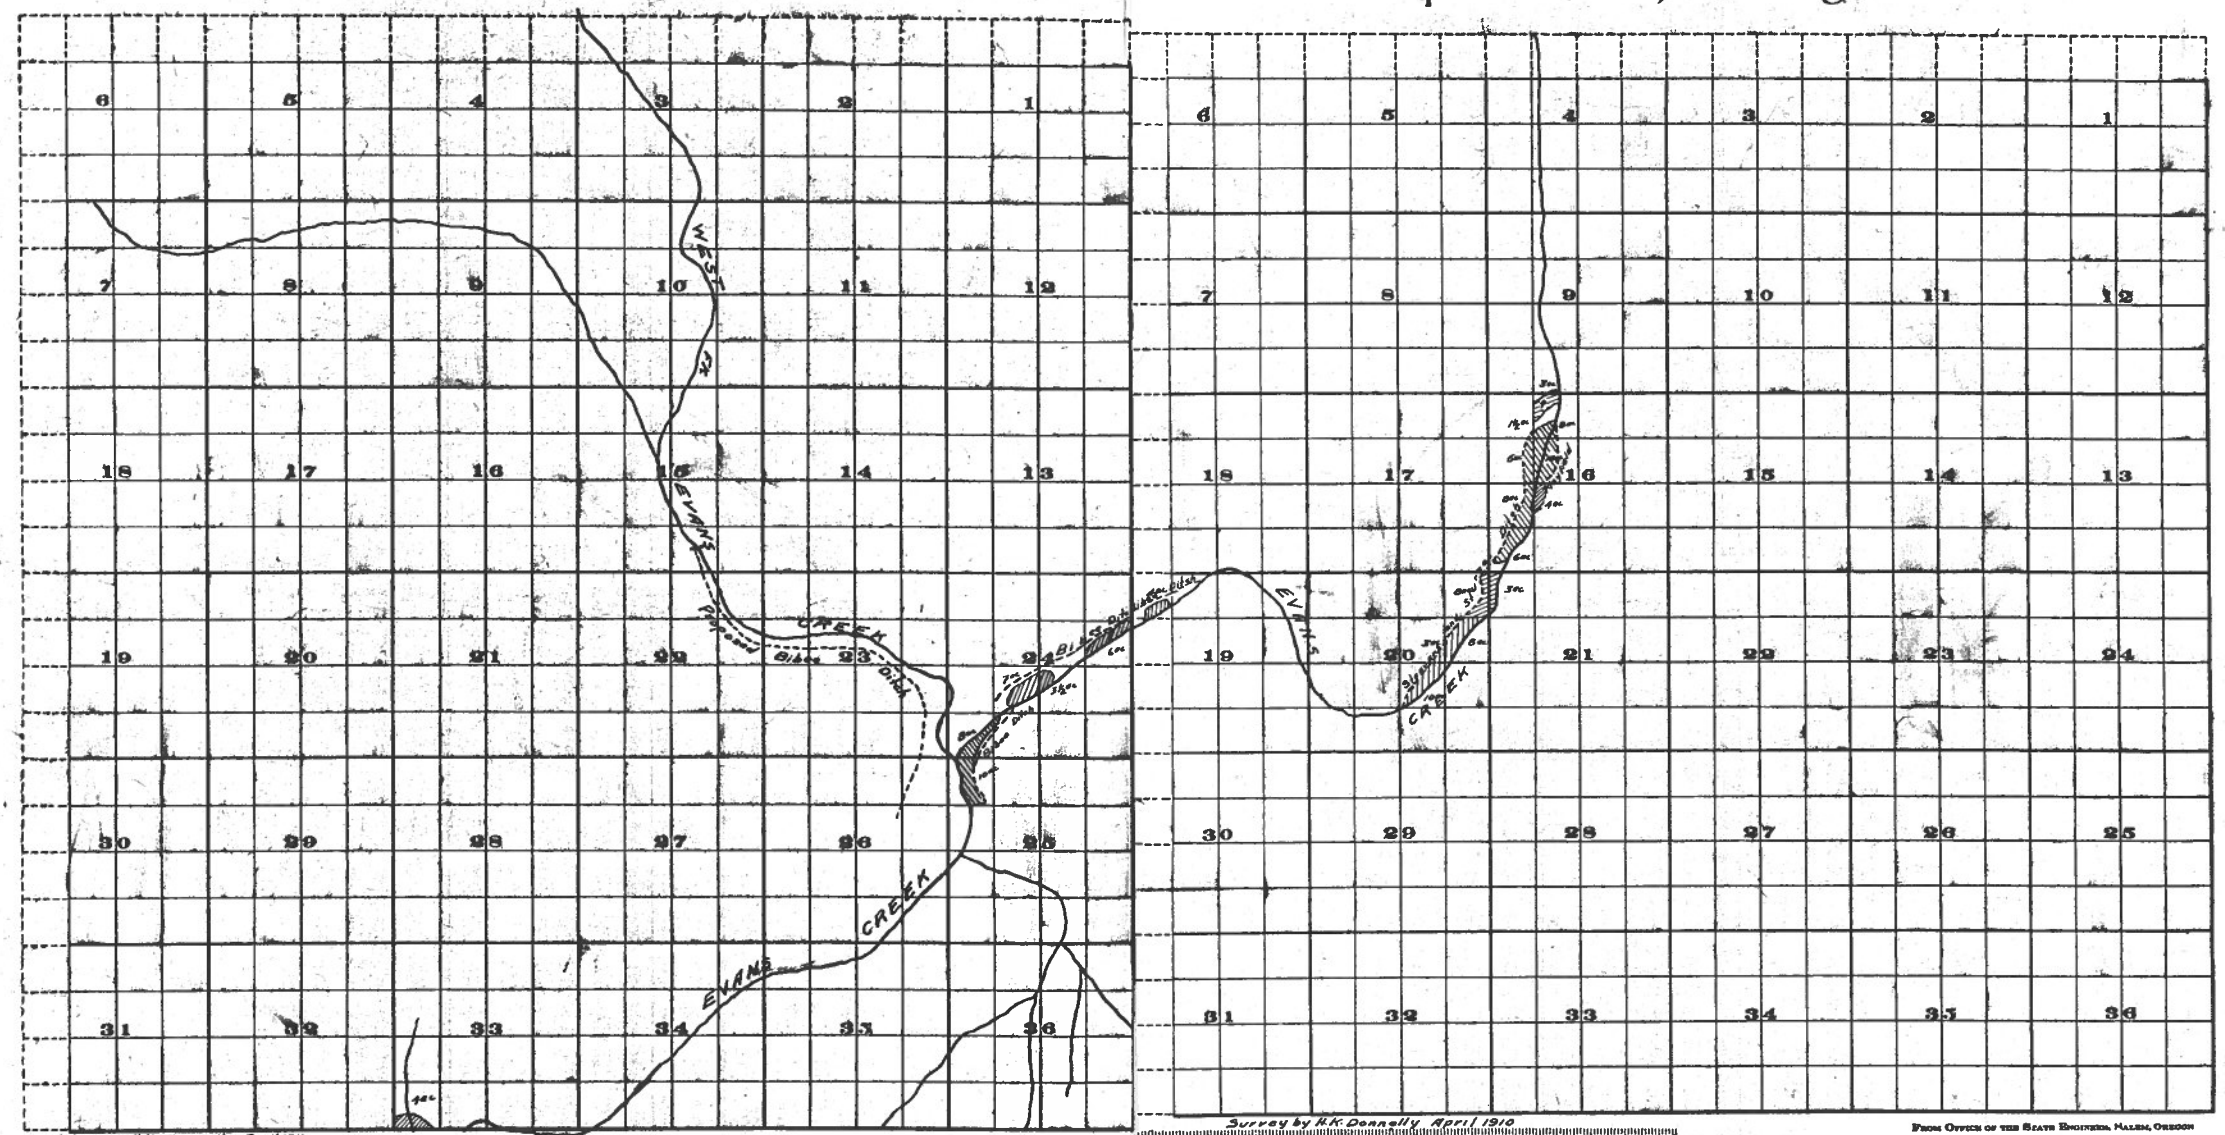

Survey by R.K. Donnelly April 1910  
 Scale of Feet.


Adjudication  
 Rogue River and Tributaries  
 John H. Lewis State Engr

Examined Sept 18 1911



