



T. 37 & 38 S., R. 11 E., W.M.

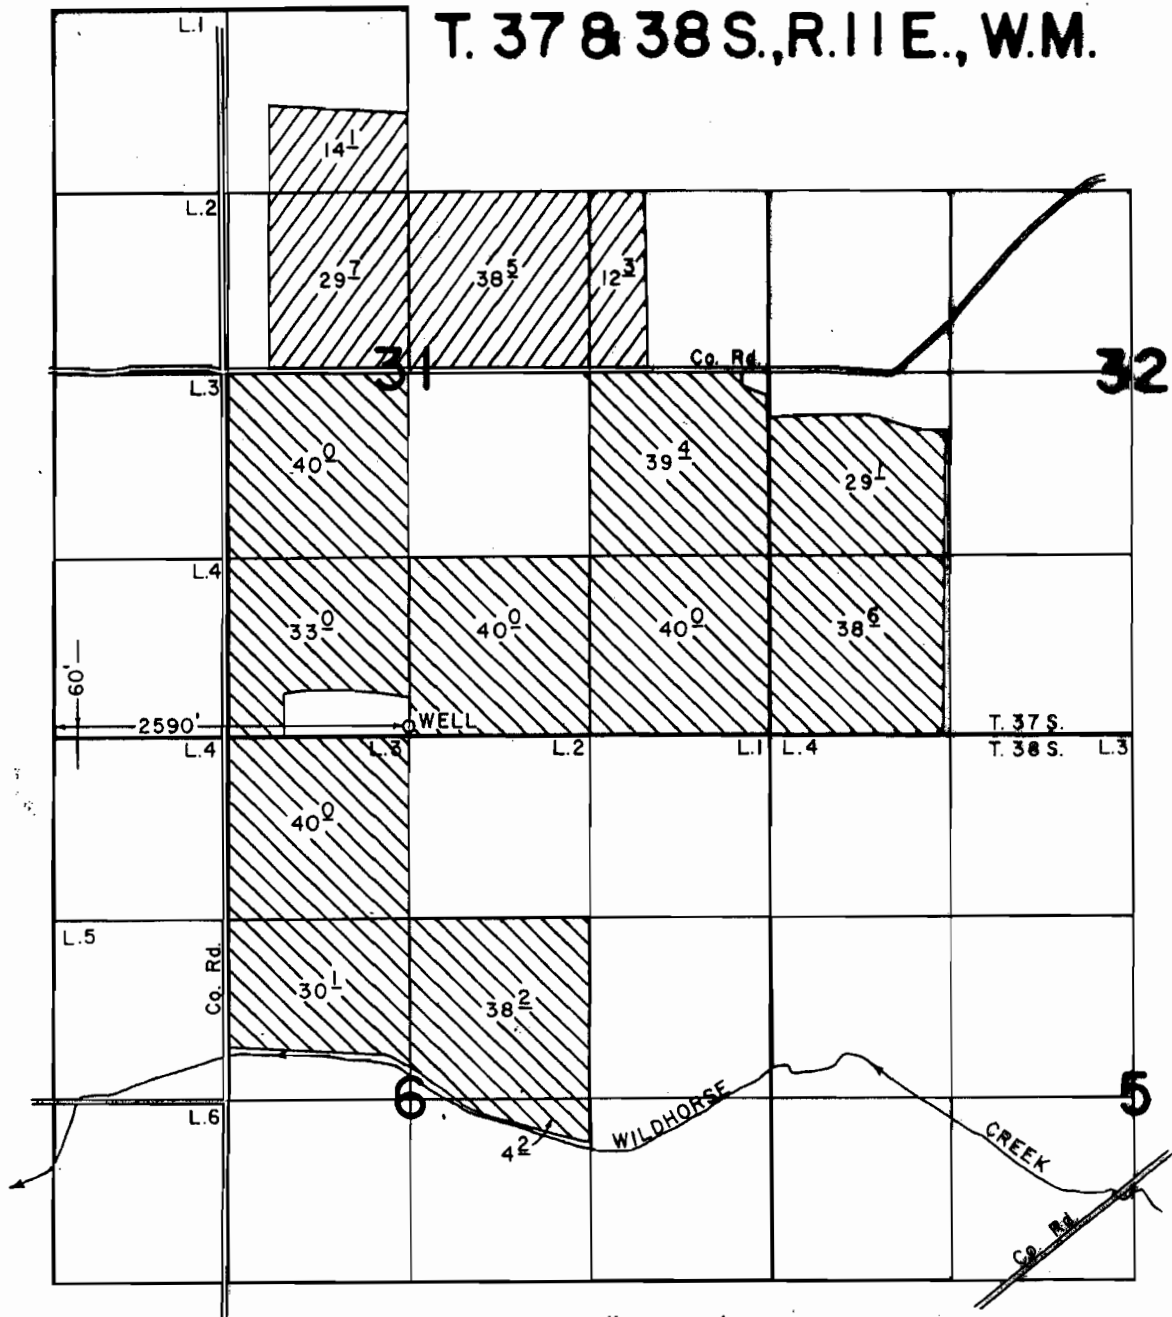

SCALE: 1" = 1320'

FINAL PROOF SURVEY
UNDER

G-10429 G-9424 

Application No. G-6868 Permit No. G-6404... 
IN NAME OF

MICHAEL B. JAGER

Surveyed SEPT. 25, 1989, by R. W. BISHOP....