T.36S. R.1W, W.M.
SECTION 4 1" = 300'

WORK COPY

RECEIVED
FEB 2 6 2007
WATER RESOURCES DEPT.
SALEM, OREGON

REVISED CORRECTED
ADJUSTED SCALE
1" = 300 FEET
DEEPEST PART 7' (only small amt is that deep)
most is 5'+ under.

T 36S R 1W
SECTION 4

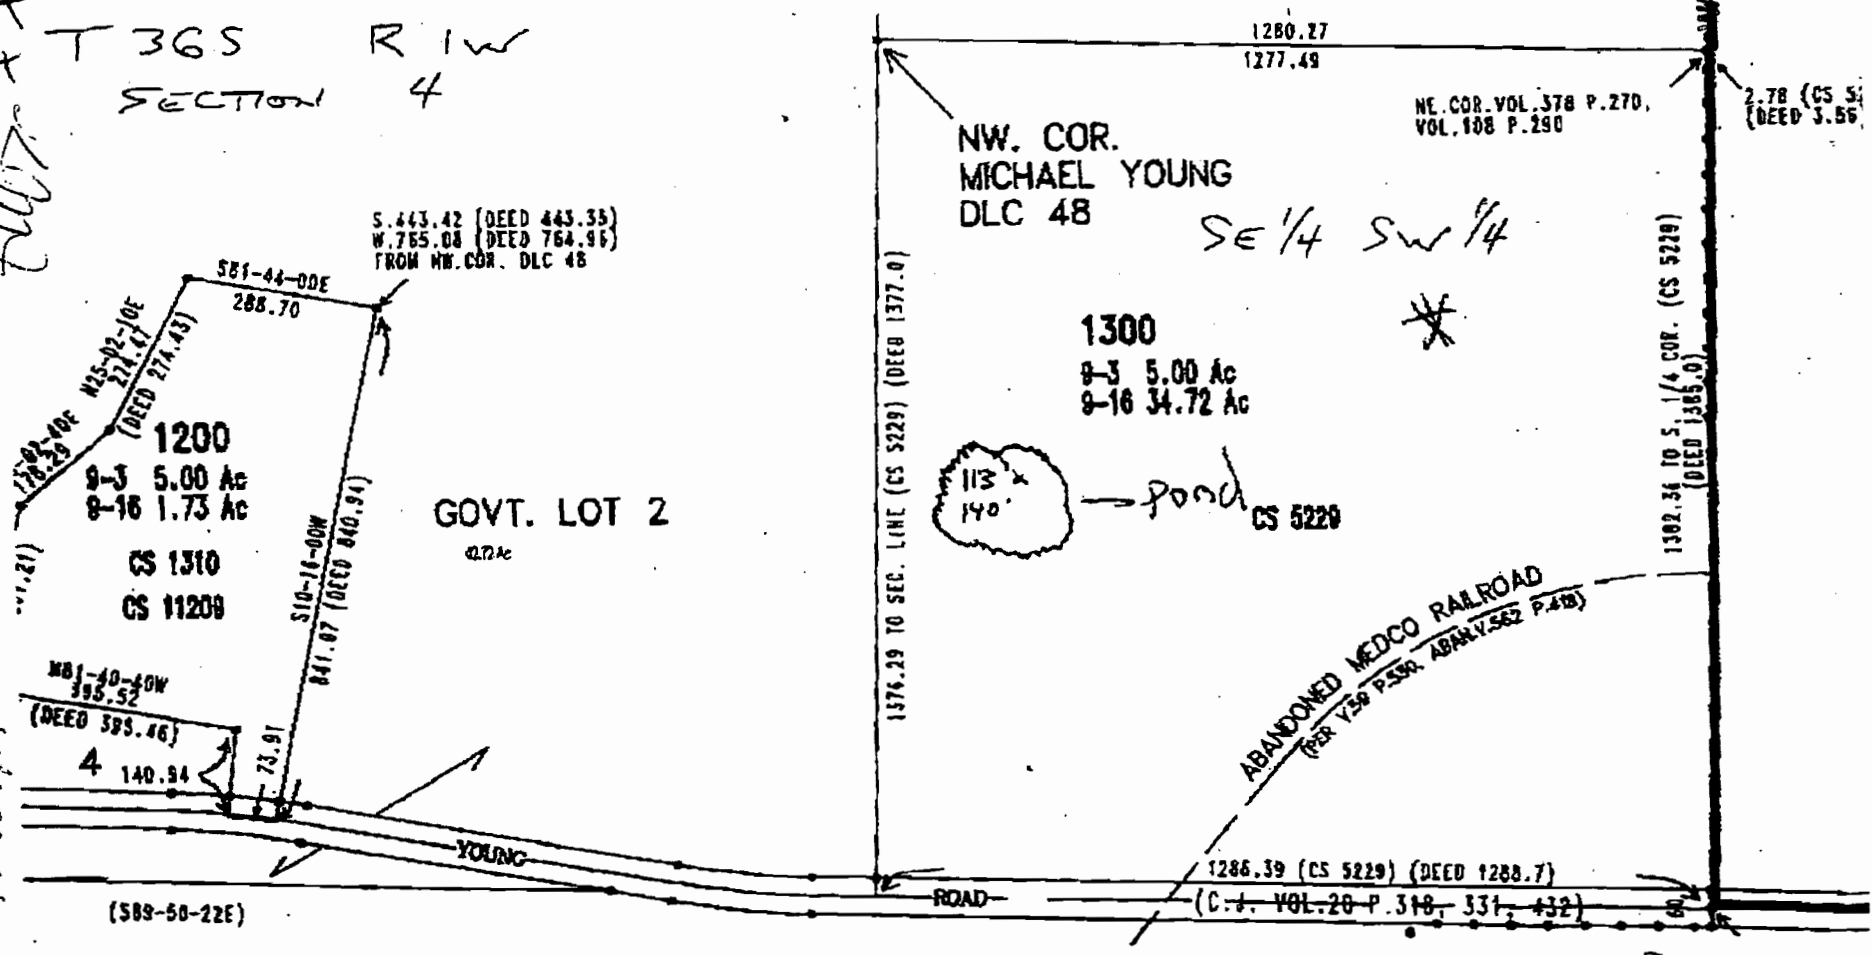

SOUTH
1/4 CORNER

POND LOCATED from
SOUTH 1/4 CORNER
630 ft NORTH & 1120 ft WEST

Initialed: Cuff & [illegible]
Sent 10-30-06 pg 3 of 4

Agree with map & details - Thank you

5412453556
WRD 1ST FL
PAGE 03/04
Kathy Johnson
5039860901
30 06 06:11p
10/30/2006 16:18
RECEIVED
OCT 3 0
WATER RESOURCES
SALEM, OREGON