


T.19S.R.3W.W.M.

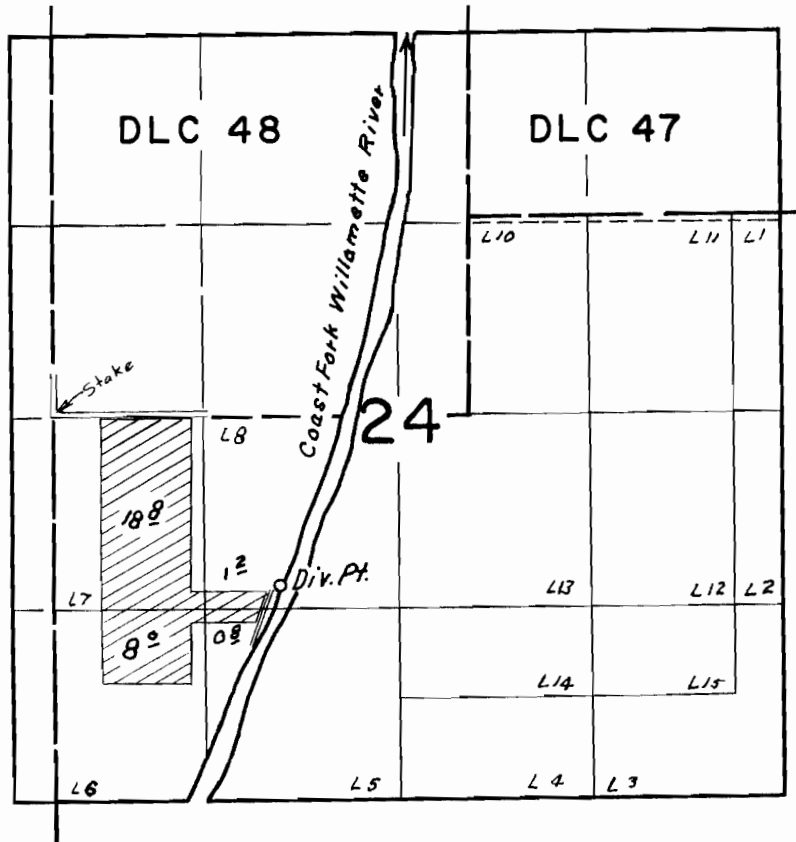

FINAL PROOF SURVEY
UNDER

Application No. 37252... Permit No. 27754...
IN NAME OF

GLENN WICKS

Surveyed ..July..9., 1964., by R...Jackson.....