




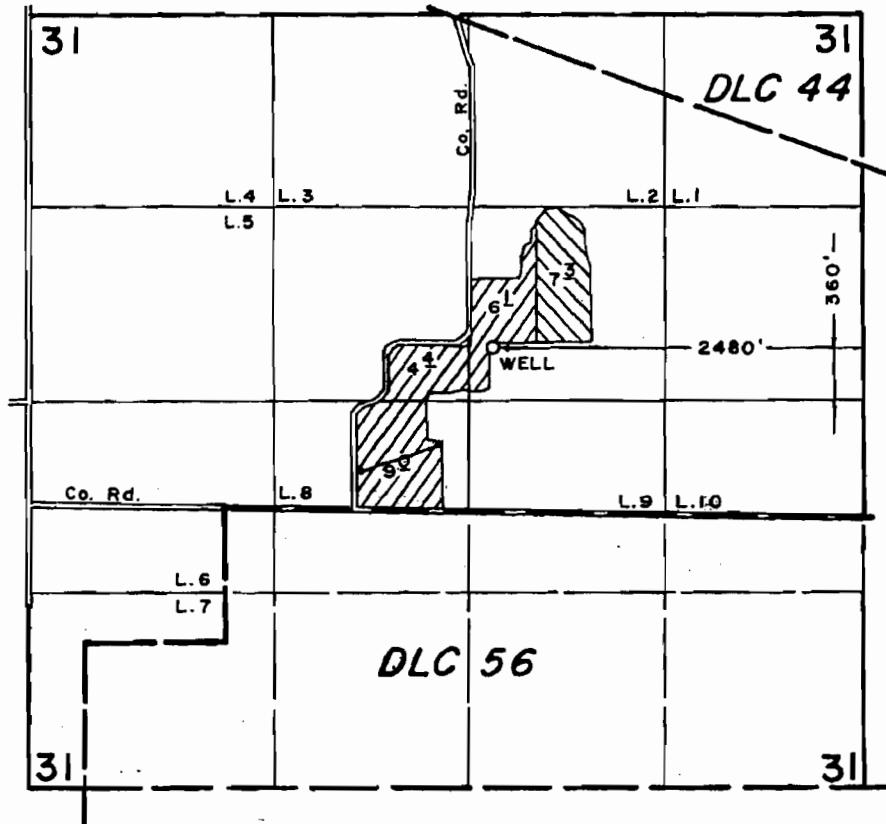

T. 5 S., R. 1 W., W.M.



SCALE: 1" = 1320'

**FINAL PROOF SURVEY
UNDER**

 Primary
 Suppl'

Application No. G-11293 Permit No. G-10415
IN NAME OF

CLARENCE SCHLECTER

Surveyed MAY 24, 1990, by T. M. WARREN.

6-7-90
41047-178-126A