







T.5S. R.3W. Section 28

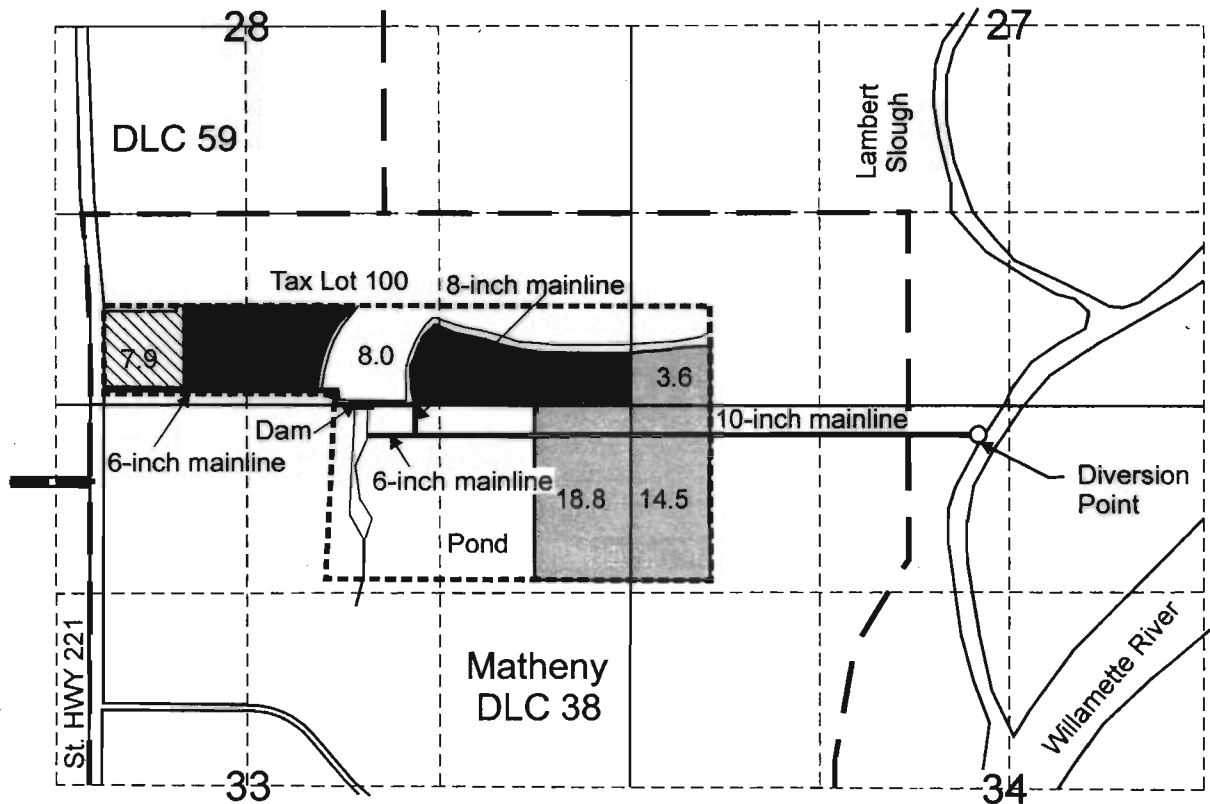


Authorized diversion point is located 1,600 feet south and 510 feet east from the northeast corner of Matheny DLC 38.

-  Area (24.1 acres) irrigated from Permit S-13847 with supplemental from Permit S-51918
-  Area (7.9 acres) irrigated from Permit S-27687 with supplemental from Permit S-51918
-  Area (36.9 acres) irrigated from Permit S-28613
-  Tax lot boundary

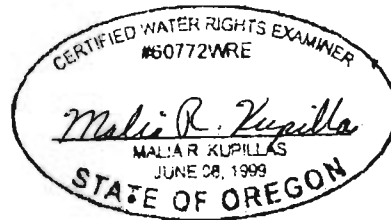

EXPIRATION DATE: 6/30/05

Scale: 1" = 1,320'

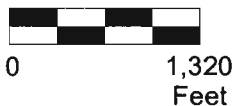

This map was prepared for the purpose of identifying the location of a water right only and is not intended to provide legal dimensions or location of property ownership lines.



Claim of Beneficial Use T-8741

Carlton Plants
T.5S. R.3W. Section 28, Tax Lot 100

Pacific Hydro-Geology Inc.