


# T. 37 & 38 S., R. 11 E., W.M.

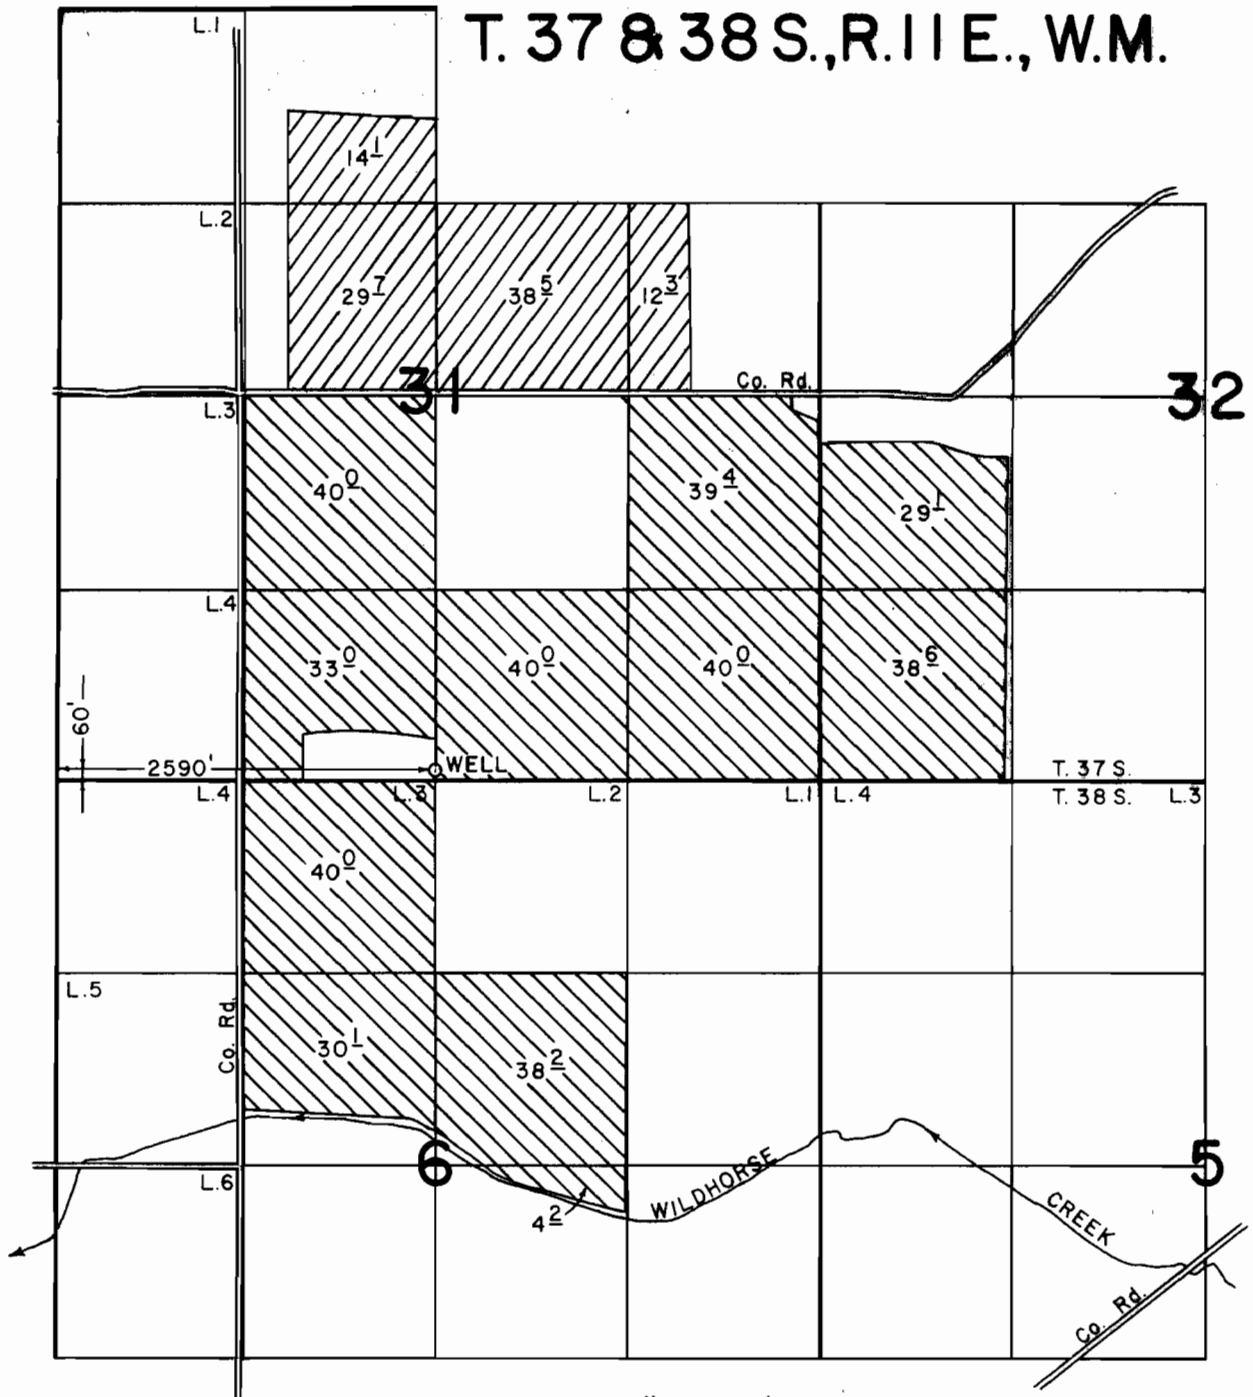

SCALE: 1" = 1320'

## FINAL PROOF SURVEY UNDER

G-10429

G-9424



Application No. G-6868 Permit No. G-6404



IN NAME OF

**MICHAEL B. JAGER**

Surveyed SEPT. 25, 1989, by B.W. BISHOP