


T. 3S., R. 5E., S.W. 1/4 SEC. 18 W.M.

THE PURPOSE OF THIS MAP IS TO IDENTIFY THE LOCATION OF THE WATER RIGHT. IT IS NOT INTENDED TO PROVIDE INFORMATION RELATIVE TO THE LOCATION OF PROPERTY OWNERSHIP OR BOUNDARY LINES.

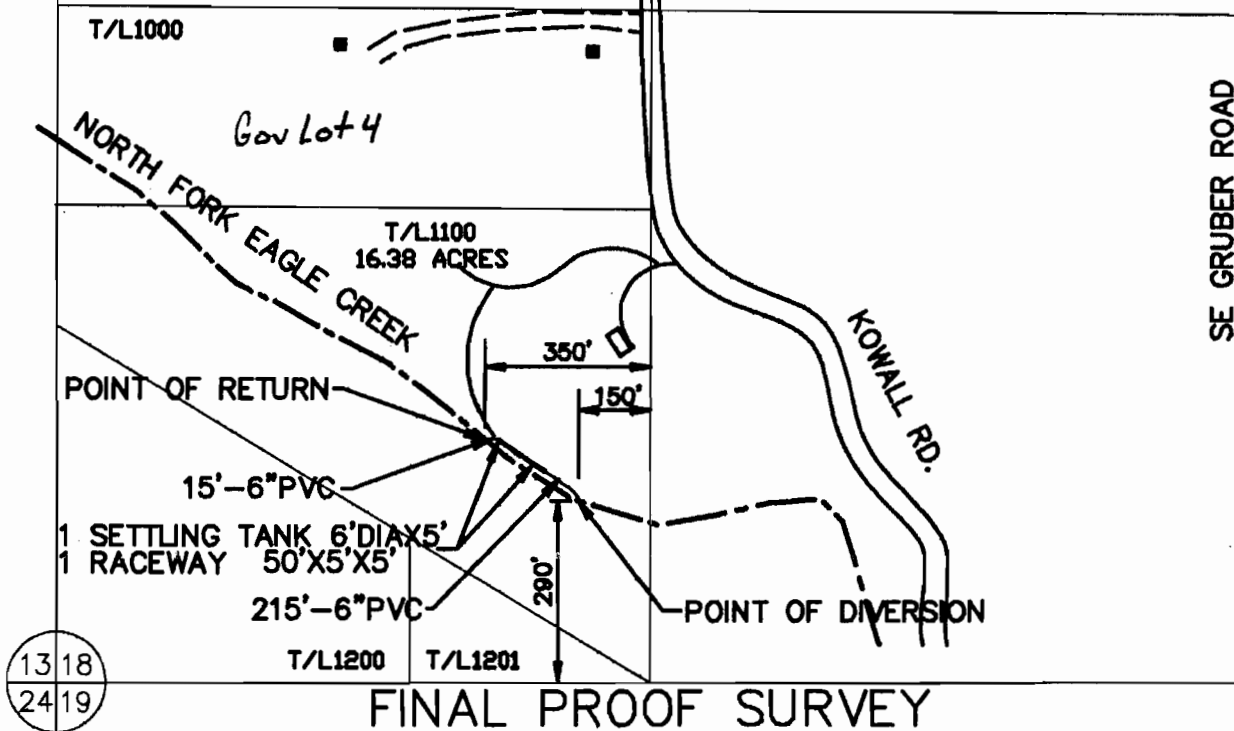

UNDER

APPLICATION NO. 71156 PERMIT NO. 51200

IN NAME OF

DAVID A. AND MARY A. BUGNI

SCALE: 1"=400'

Gov Lot 4 added to map by owner DC 8-22-2007

kpff

Consulting Engineers
707 S.W. Washington St.
Suite 800
Portland, Oregon 97205
503-227-3251

SURVEYED

BY

CWRE-151

DRAWN BY: TLA

JOB NO.: 91007.01

DATE: 8/9/94

91007-1

DRAWING NO.