


T.10S., R.6E., W.M.

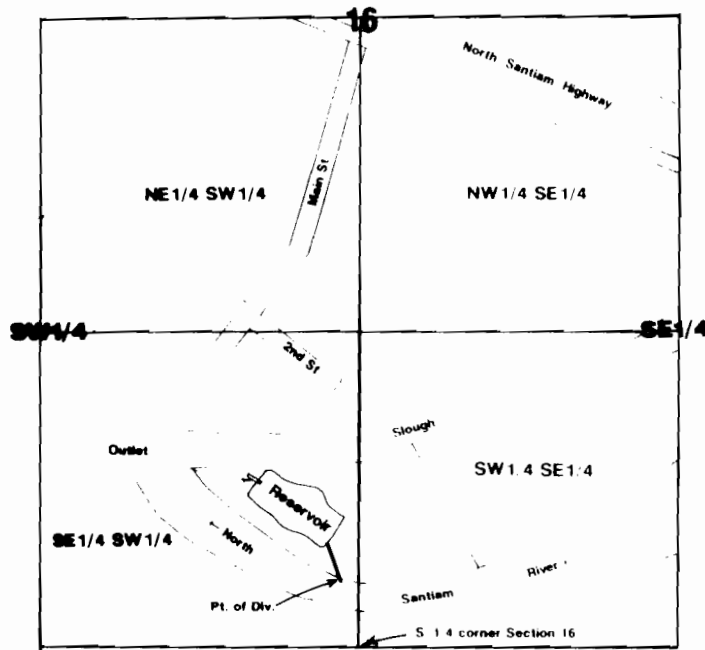

1" = 400'

Pt. of Div. located 140'N & 40'W from S1/4 corner Section 16.

Reservoir Outlet located 350'N & 210'W from S1/4 corner Section 16.


Final Proof Survey

Application #: R-70580 Permit #: R-11343 1/2
70581 51147

In Name Of

Al Clark

Surveyed on January 4, 1992 by JM Schuette

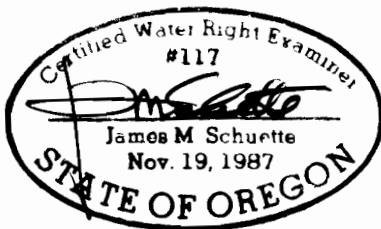

THIS MAP WAS PREPARED FOR THE PURPOSE OF IDENTIFYING THE LOCATION OF A WATER RIGHT ONLY AND IS NOT INTENDED TO PROVIDE LEGAL DIMENSIONS OR LOCATION OF PROPERTY OWNERSHIP LINES.

RECEIVED

JUL 22 1992

WATER RESOURCES DEPT.
SALEM, OREGON