

RECEIVED




T. 29 S. R. 15 W. W M.

WATER RESOURCES DEPT.
SALEM OREGON

FINAL PROOF SURVEY UNDER

APPLICATION NO. 69316
R.69315

PERMIT NO. 50167
RI 0890

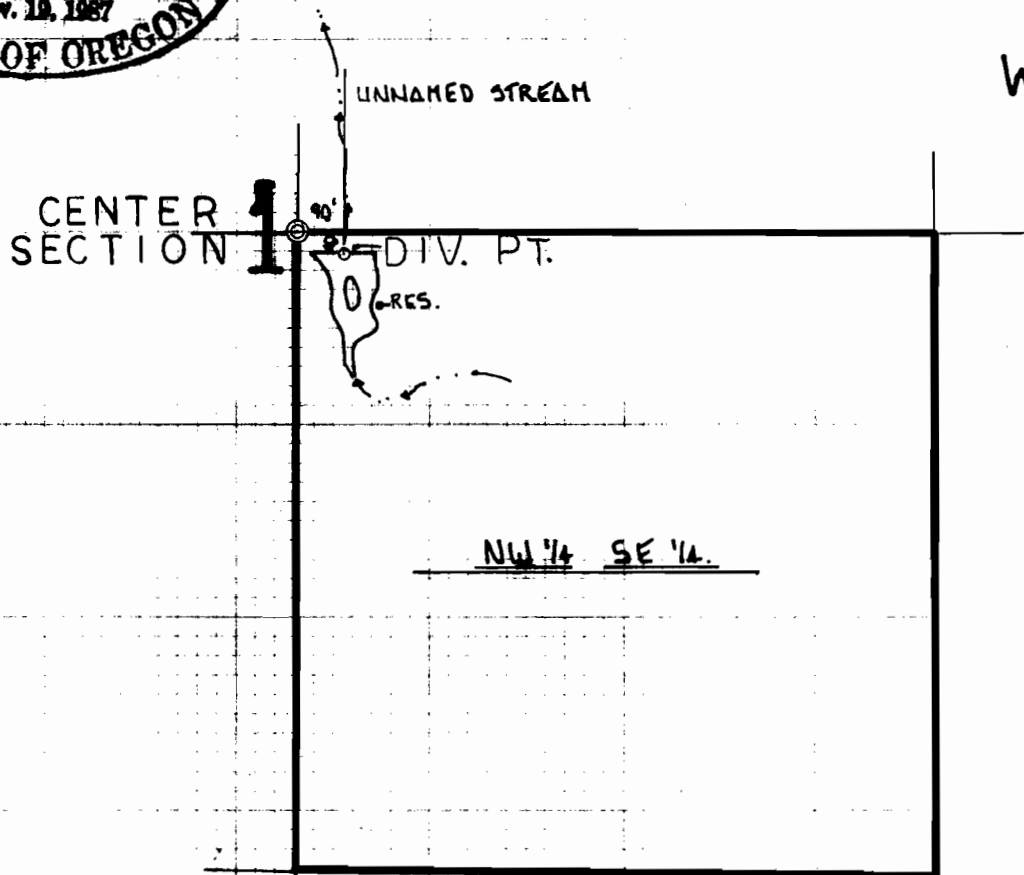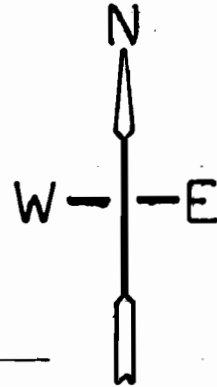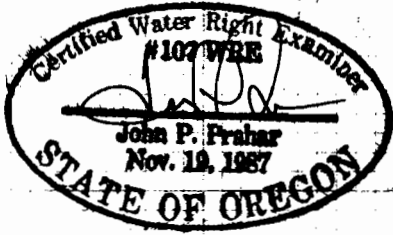

IN THE NAME OF

LEOPOLD LEWANDOWSKI

SURVEYED: FEB. 16, 1990 BY:

[Signature]