


T.48&5N., R.25E., W. M.

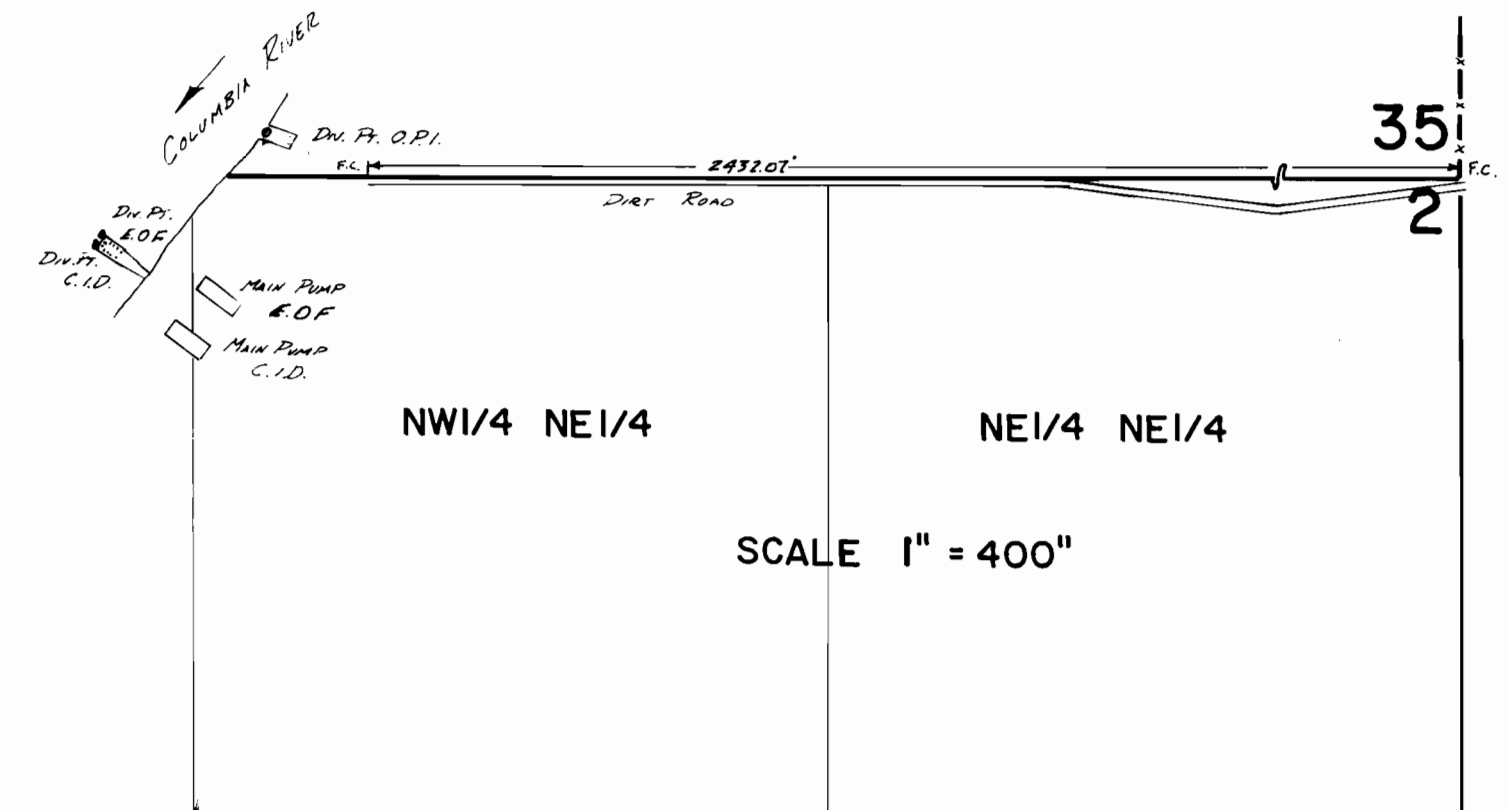

D.V. Pt. O.P.I. Loc: 85' N. + 2640' W. FROM SE COR SEC 35
D.V. Pt. E.O.F. Loc: 120' S. + 2980' W FROM NE COR. SEC 2
D.V. Pt. C.I.D. Loc: 150' S. + 2995' W FROM NE COR. SEC 2

200 2 28

FINAL PROOF SURVEY


UNDER

Application No. 51650 Permit No.
IN NAME OF

Surveyed JAN. 14 1983, by V.L. Church

E-23-5


T. 2 & 3 N., R. 26 E., W.M.

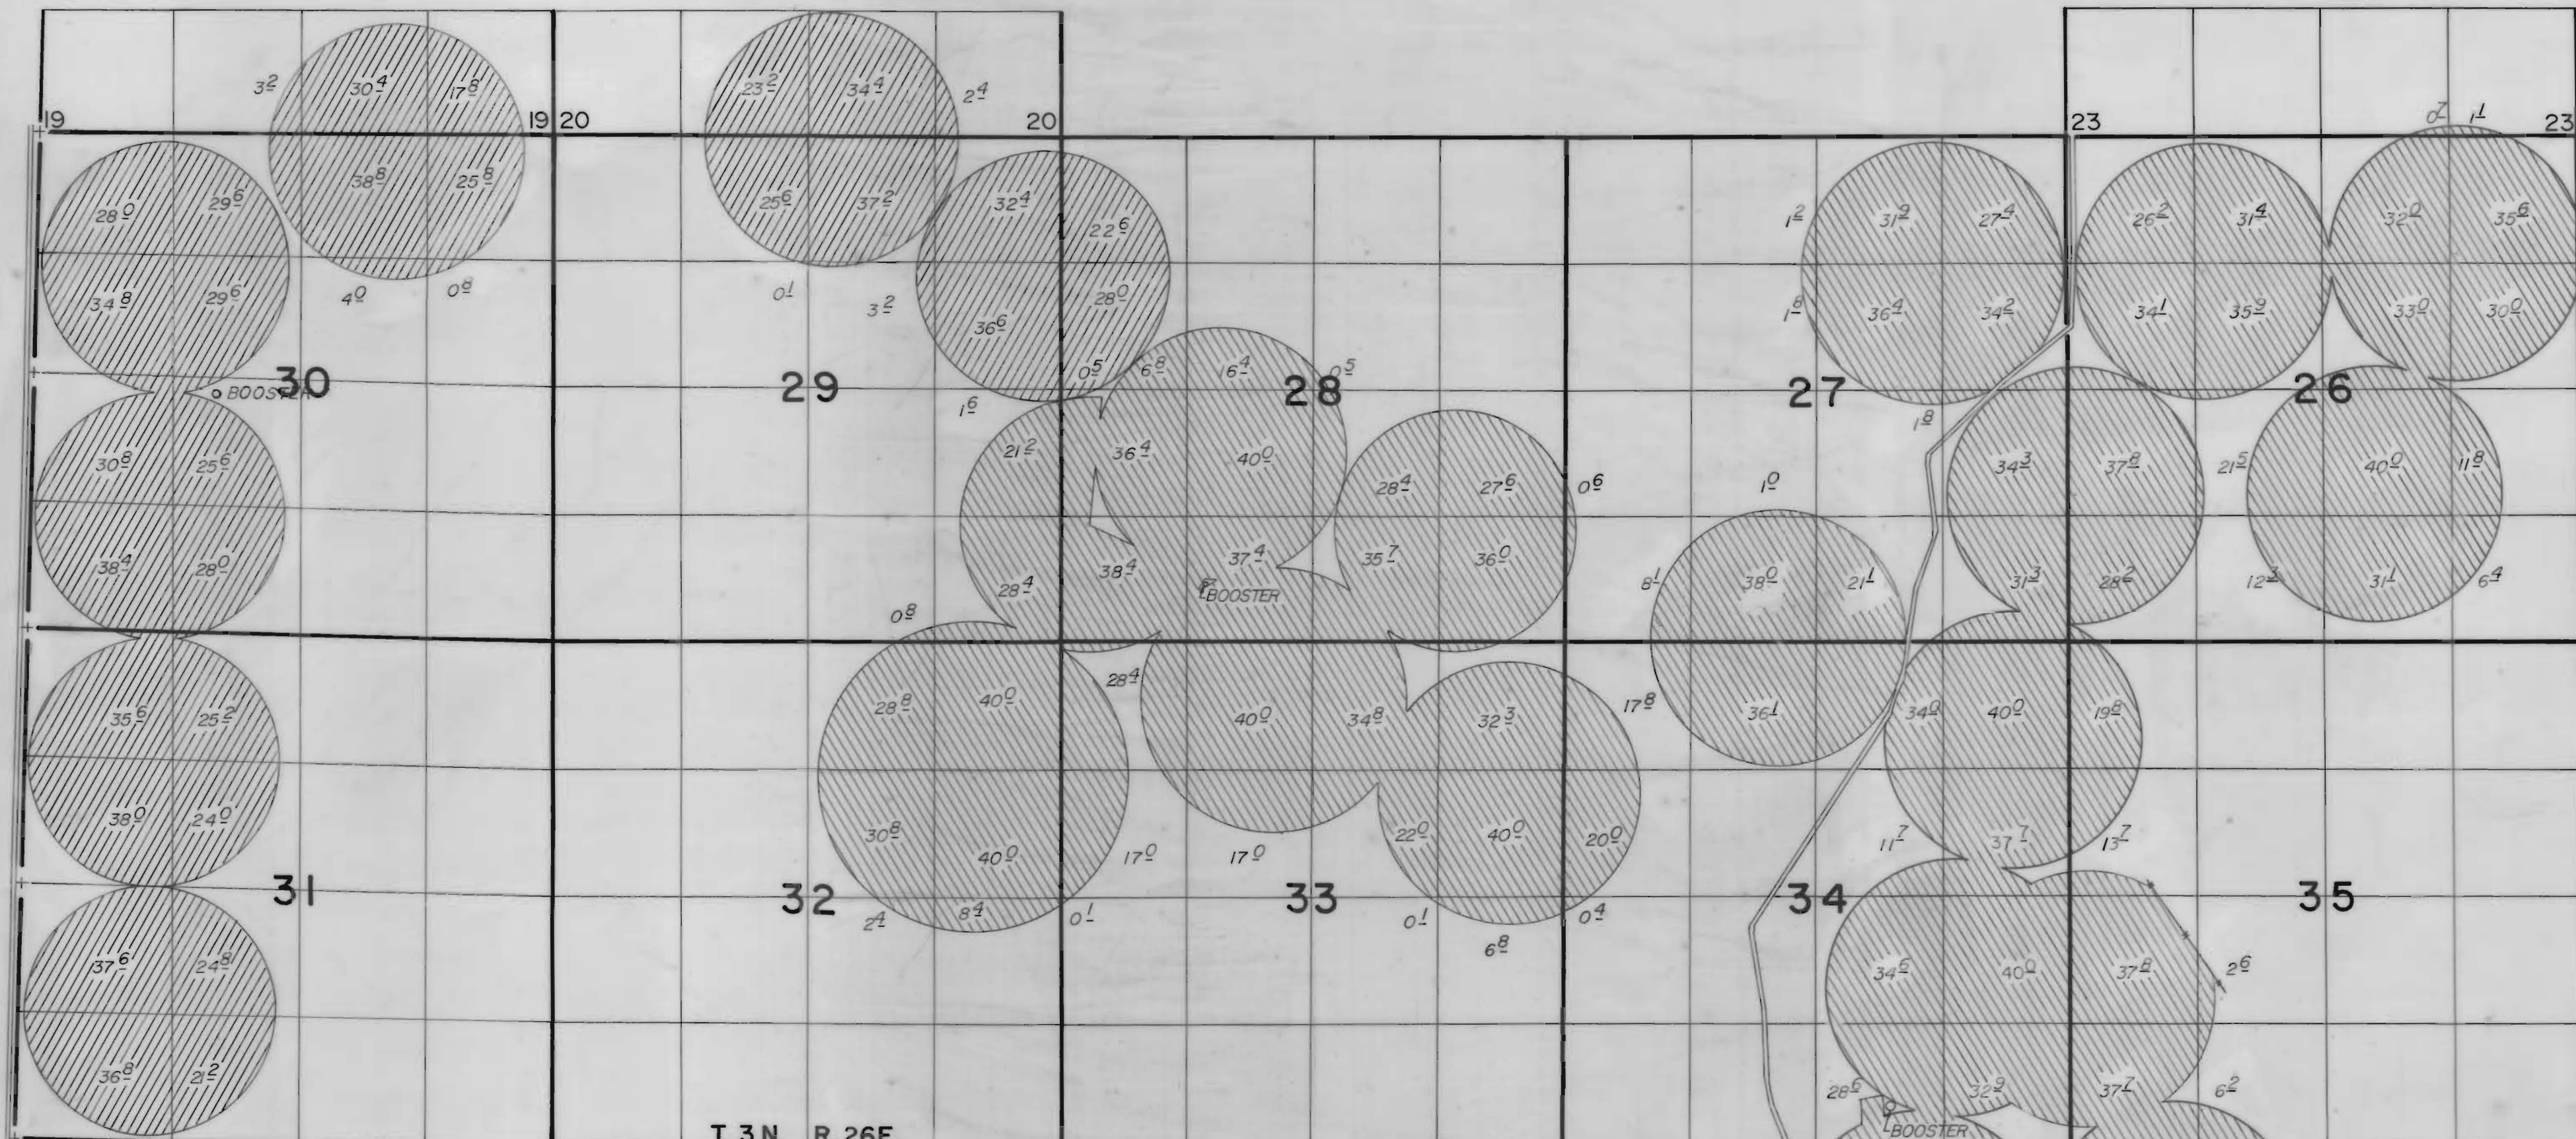

T. 3 N. R. 26 E.
T. 2 N. R. 26 E.

SCALE : 4" = 1 MILE

T. 4N, R. 25E., W.M.

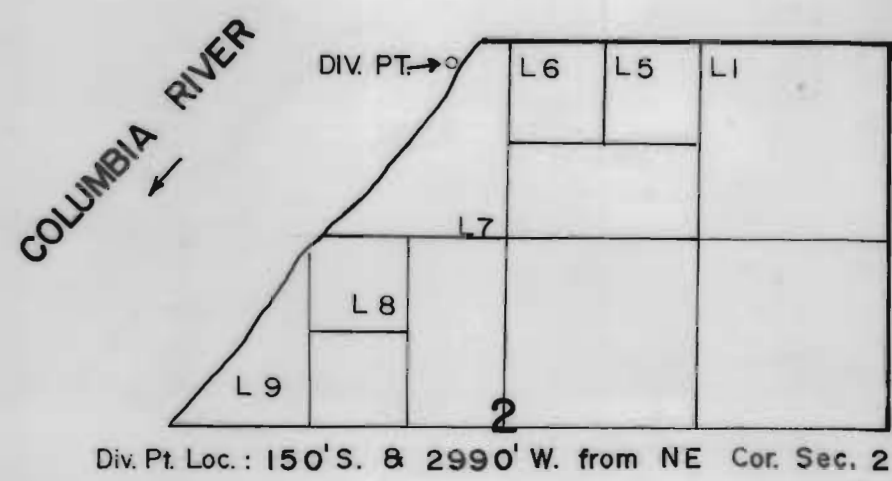

-  SABRE
-  LINDSAY
-  REPP

FINAL PROOF SURVEY
UNDER

APPL. NO. 51650 PER. NO. 37293

IN NAME OF
CONNECTICUT GENERAL LIFE INS. CO.
&
FIRST INTERSTATE BANK OF OREGON

SURVEYED 8-8-76 BY R. MUCKEN (SABRE)
5-3-79 R. BARWIN (LINDSAY)
11-15-79 V. CHURCH (REPP)

