


# CLAIM OF BENEFICIAL USE SURVEY

LOCATED IN THE NORTHWEST ONE-QUARTER OF THE NORTHWEST  
ONE-QUARTER AND THE NORTHEAST ONE-QUARTER OF THE  
NORTHWEST ONE-QUARTER OF SECTION 16,  
TOWNSHIP 14 SOUTH, RANGE 13 EAST, WILLAMETTE MERIDIAN,  
DESCHUTES COUNTY, OREGON


OWNER AND PERMITTEE:  
TERRY REYNOLDS

APPLICATION FILE NO. G-15799  
PERMIT NO. G-15656  
TAX LOT NO. 107

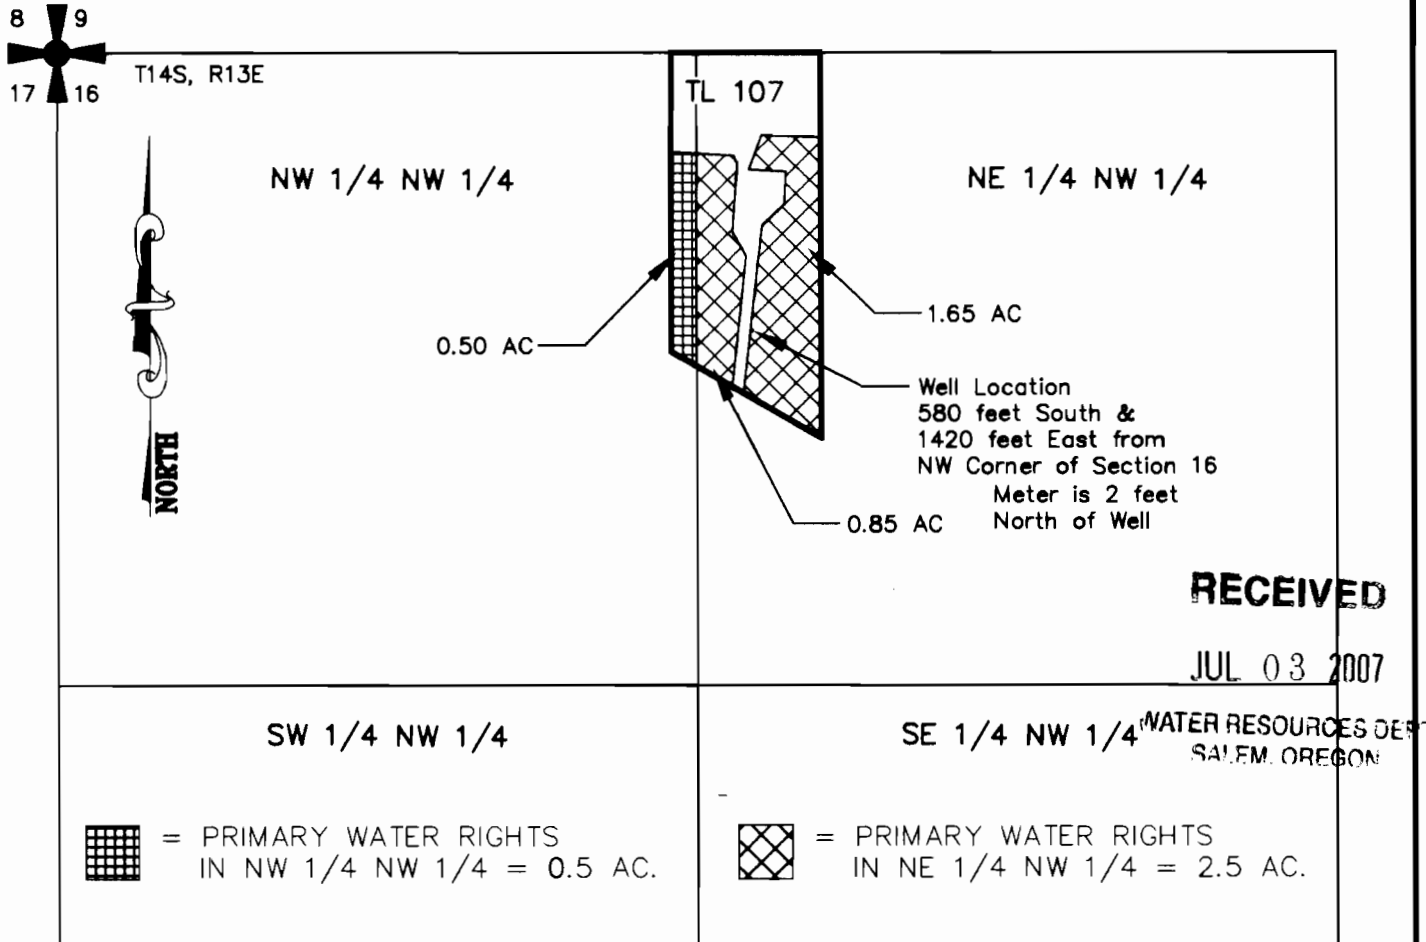

I, James R. Tye, Certified Water Right Examiner in the State of Oregon, hereby certify that this water rights survey map was prepared under my direct supervision.

The preparation of this map is for the purpose of identifying the location of the water right only and has no intent to provide dimensions or locations of property ownership lines.

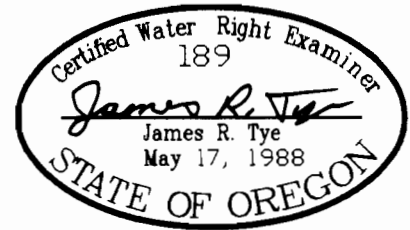

SCALE	1"=400'	DATE	6-27-07	SURVEY BY	GPS	DRAWN BY	K.B.	ORDER NO.	6877-22
-------	---------	------	---------	-----------	-----	----------	------	-----------	---------

**SUN COUNTRY ENGINEERING & SURVEYING, INC.**  
920 SE ARMOUR ROAD BEND, OREGON 97702 PHONE 382-8882