


# T. 5 N., R. 36 E., W.M.

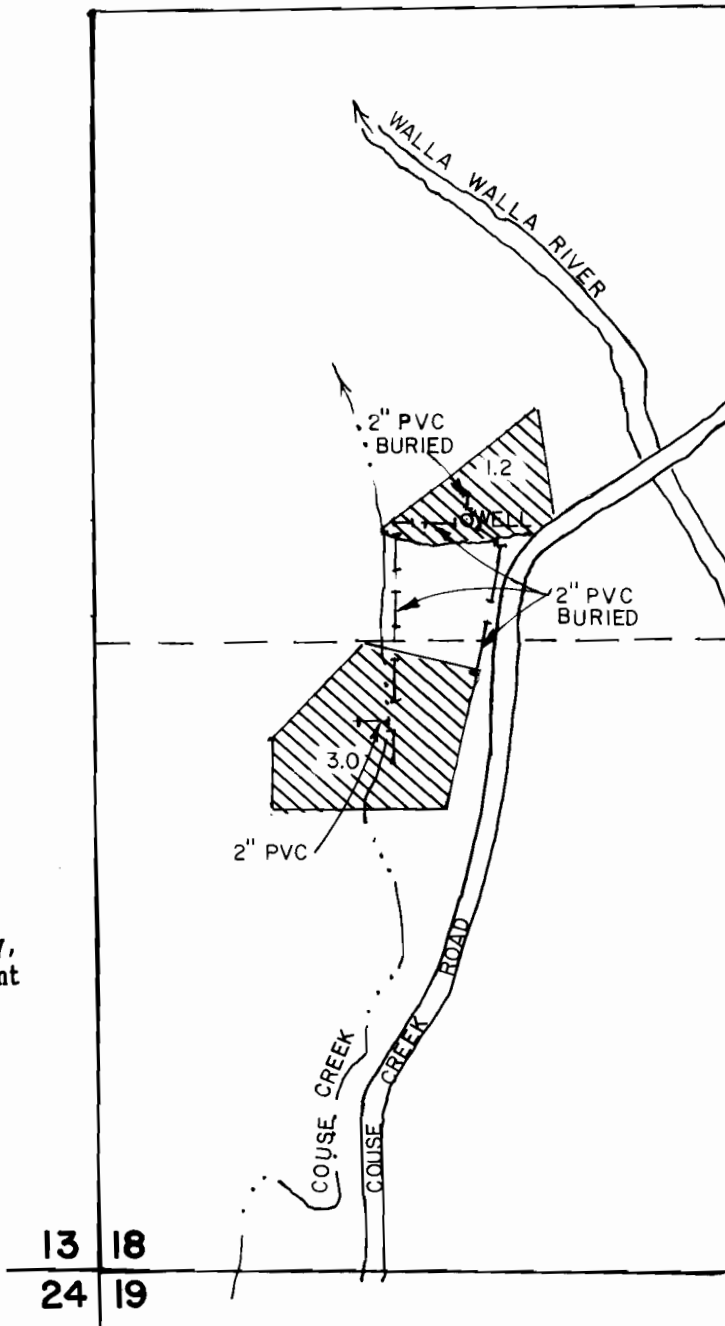

SCALE 1" = 400'

The preparation of this map was for the purpose of identifying the location of water right only, and has no intent to provide dimensions or locations of property ownership lines.

WELL LOC. 1560' N & 780' E FROM SW CORNER SEC. 18.

13 18  
24 19

## FINAL PROOF SURVEY UNDER

Application No. G-11997      Permit No. G-11310

IN NAME OF  
WALTER AND NORMA POWELL

