


T.37 S., R.32³/₄ E., W.M


370547 2

1143-93

WATER RESOURCES DEPT
SALMON, OREGON

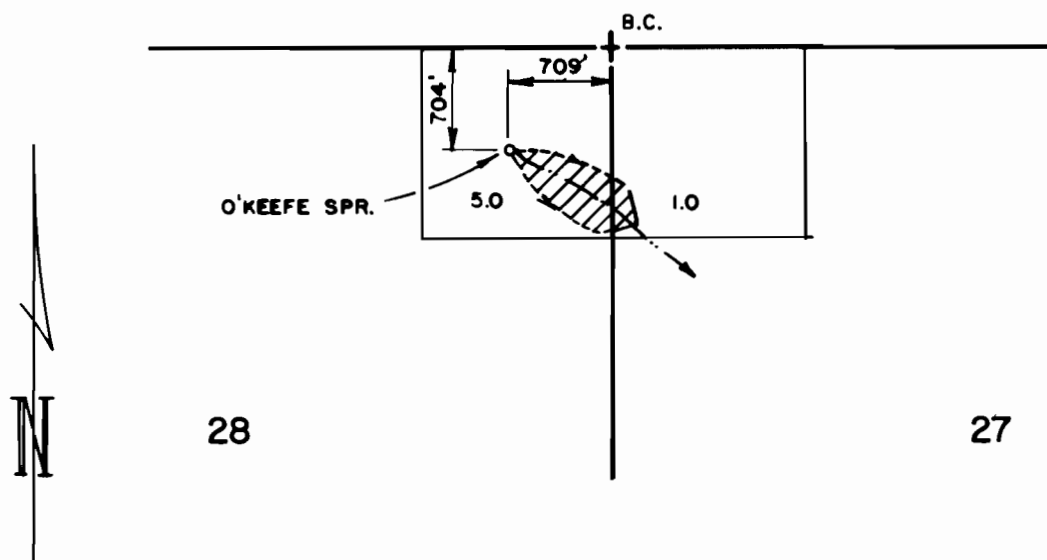

THE PURPOSE OF THIS MAP IS TO
IDENTIFY THE LOCATION OF THE
WATER RIGHT. IT IS NOT INTENDED
TO PROVIDE INFORMATION RELATIVE
TO THE LOCATION OF PROPERTY
OWNERSHIP.

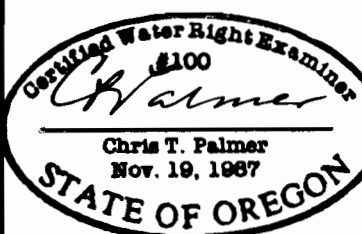	FINAL PROOF SURVEY		
	IN THE NAME OF		
	RODNEY HOAGLAND		
	UNDER		
	APPLICATION NO. 69920		Job: 1143-93
	PERMIT NO. 50704		Sht. No.
Scale: 4" = 1 MILE	Date: SEPT 1993	M. A. PALMER & SONS, INC.	
Den:	 ENGINEERING & SURVEYING 254 N. Alder - Box 61 Burns, Oregon 97720	of <u>1</u>	
Drn: CHRIS			
Ckd:			