



T. 14 S., R. 34 E., W.M.

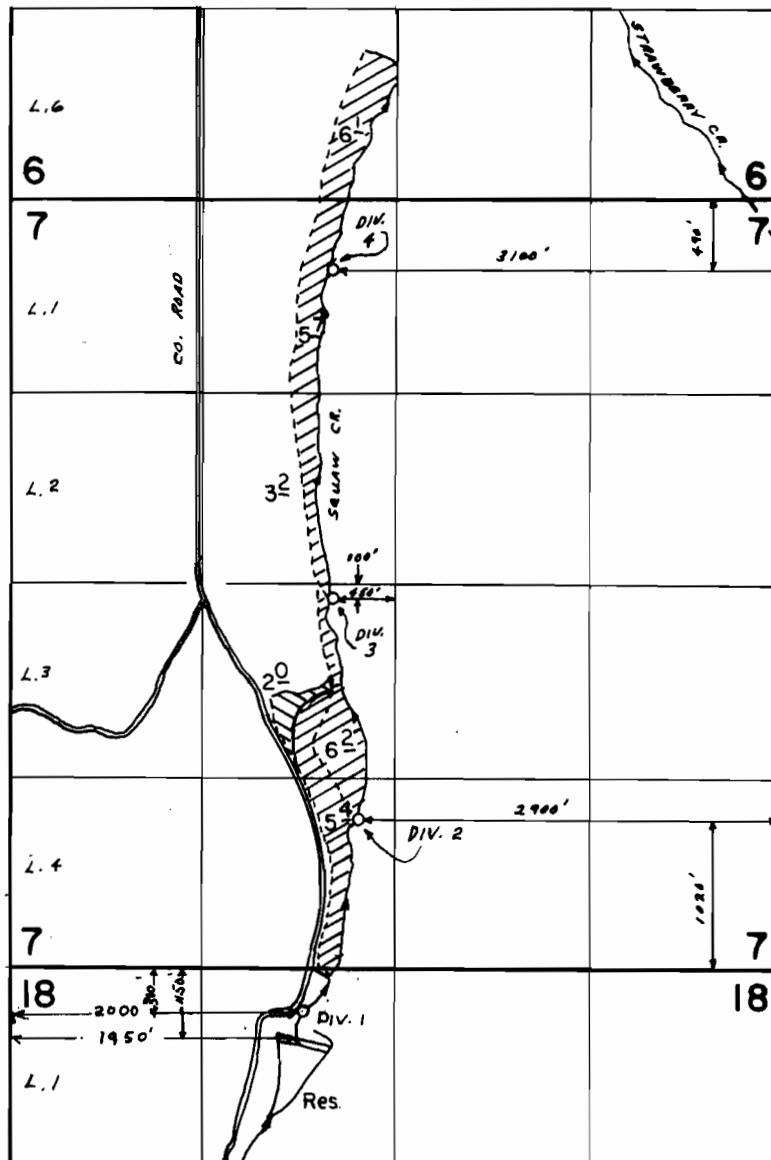

SCALE: 1"=1320'

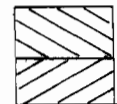

Primary
Supplemental

FINAL PROOF SURVEY UNDER

R55507

R6576

Application No. 55508 Permit No. 41540

IN NAME OF

OXBOW RANCH

Surveyed MAR. 18, 1986, by L.M. TOLL