



T. 14 S., R. 34 E., W.M.

N

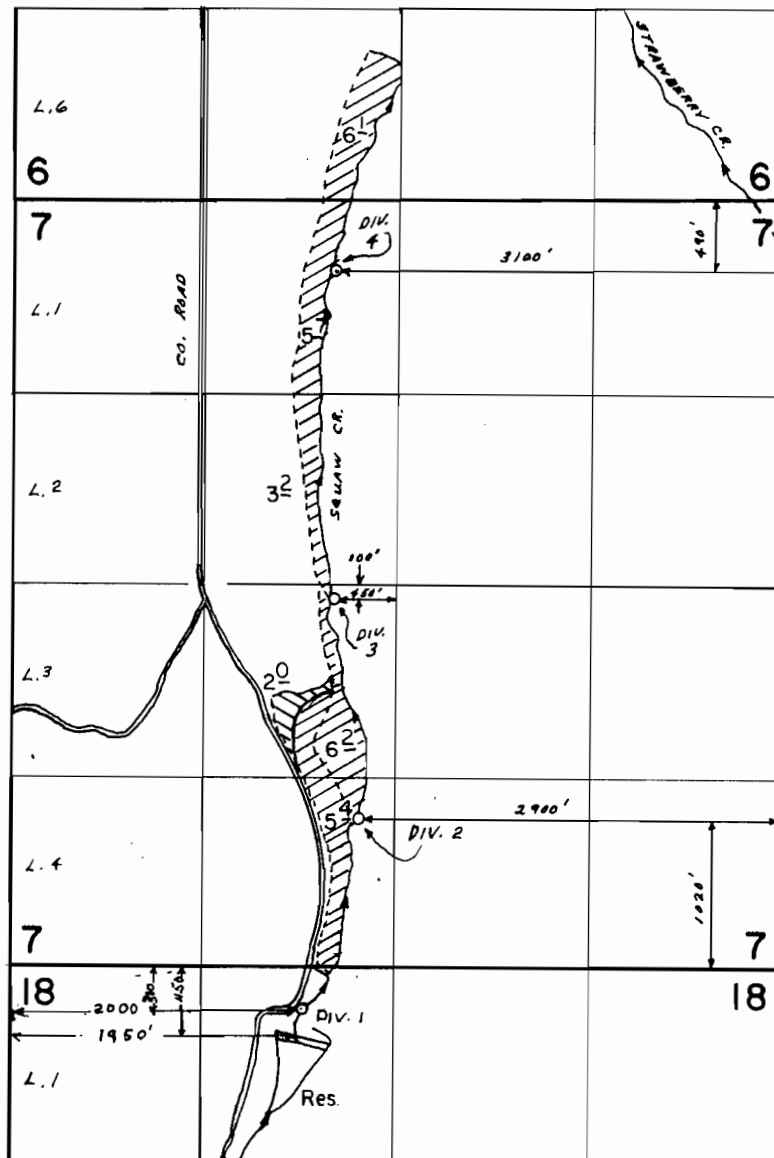

SCALE: 1"=1320'

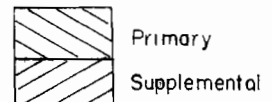

# FINAL PROOF SURVEY UNDER

R-55507 R-6576  
Application No. 55508 Permit No. 41540  
IN NAME OF

OXBOW RANCH

Surveyed MAR. 18, 1986, by L.M. TOLL