


3536

TREMONT


PARK

(RD. 417 (BET. 52ND & FOSTER) TO C.P. PER CO. OA. 27, 2-1-68)


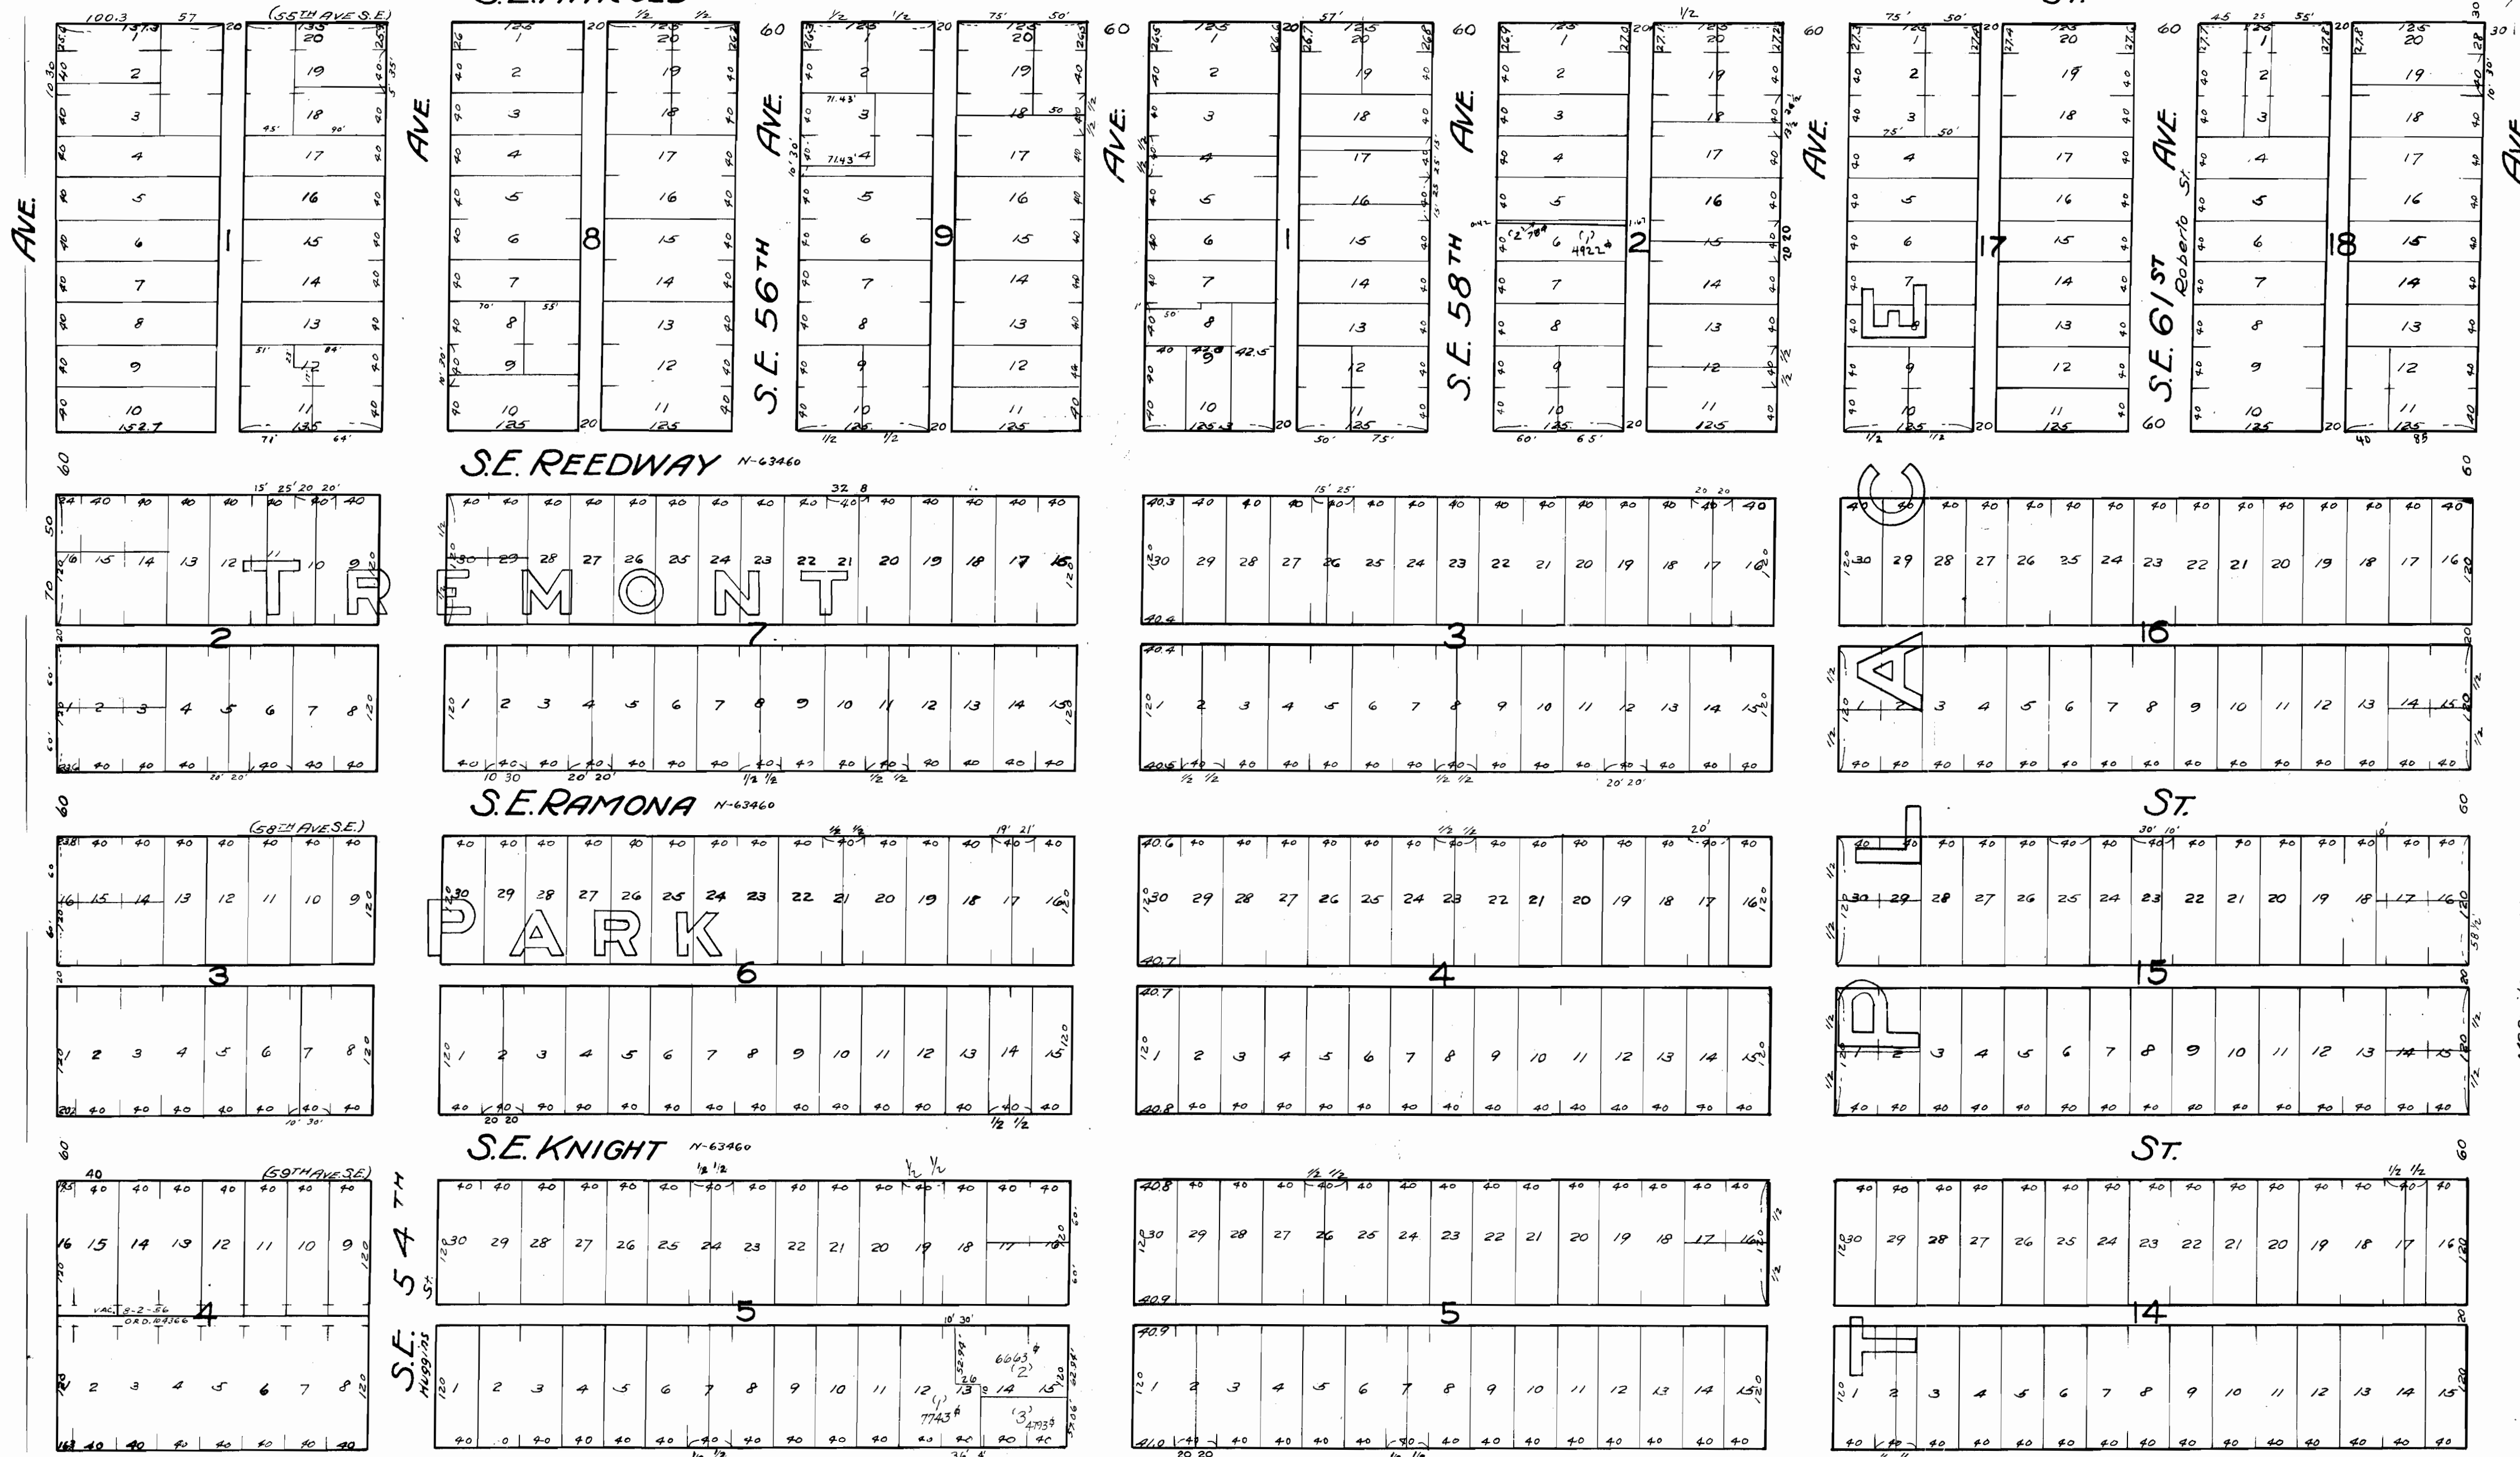


3635

3637

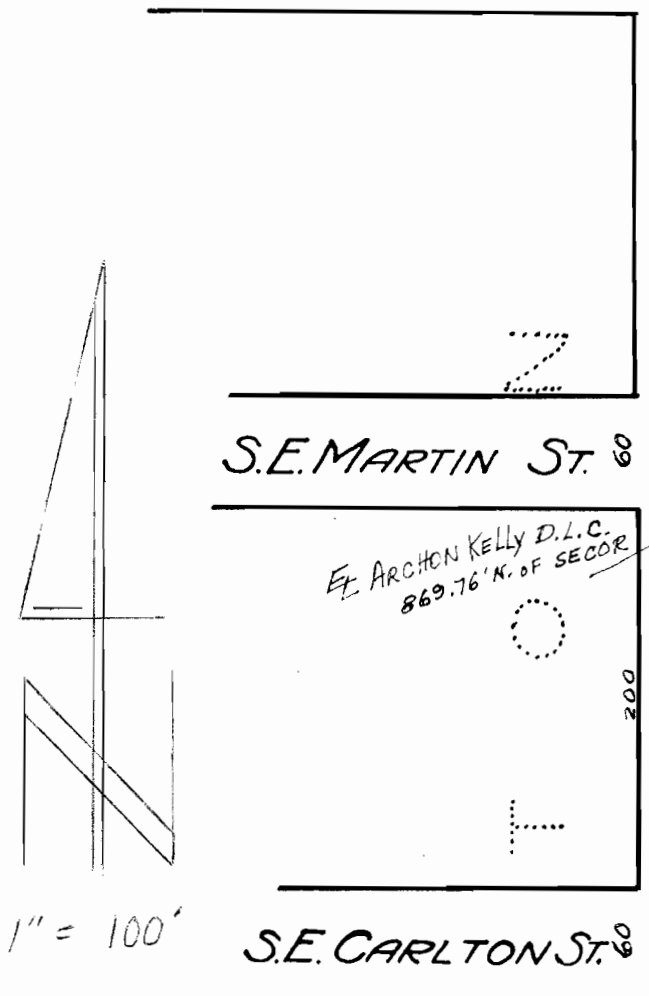


FINAL PROOF SURVEY  
 UNDER  
 Application No. G-18710, Permit No. G-10095  
 IN NAME OF  
 The American Farm Mission  
 Surveyed Dec. 13, 1991, by R.W. Klassen  
 7/10/2007

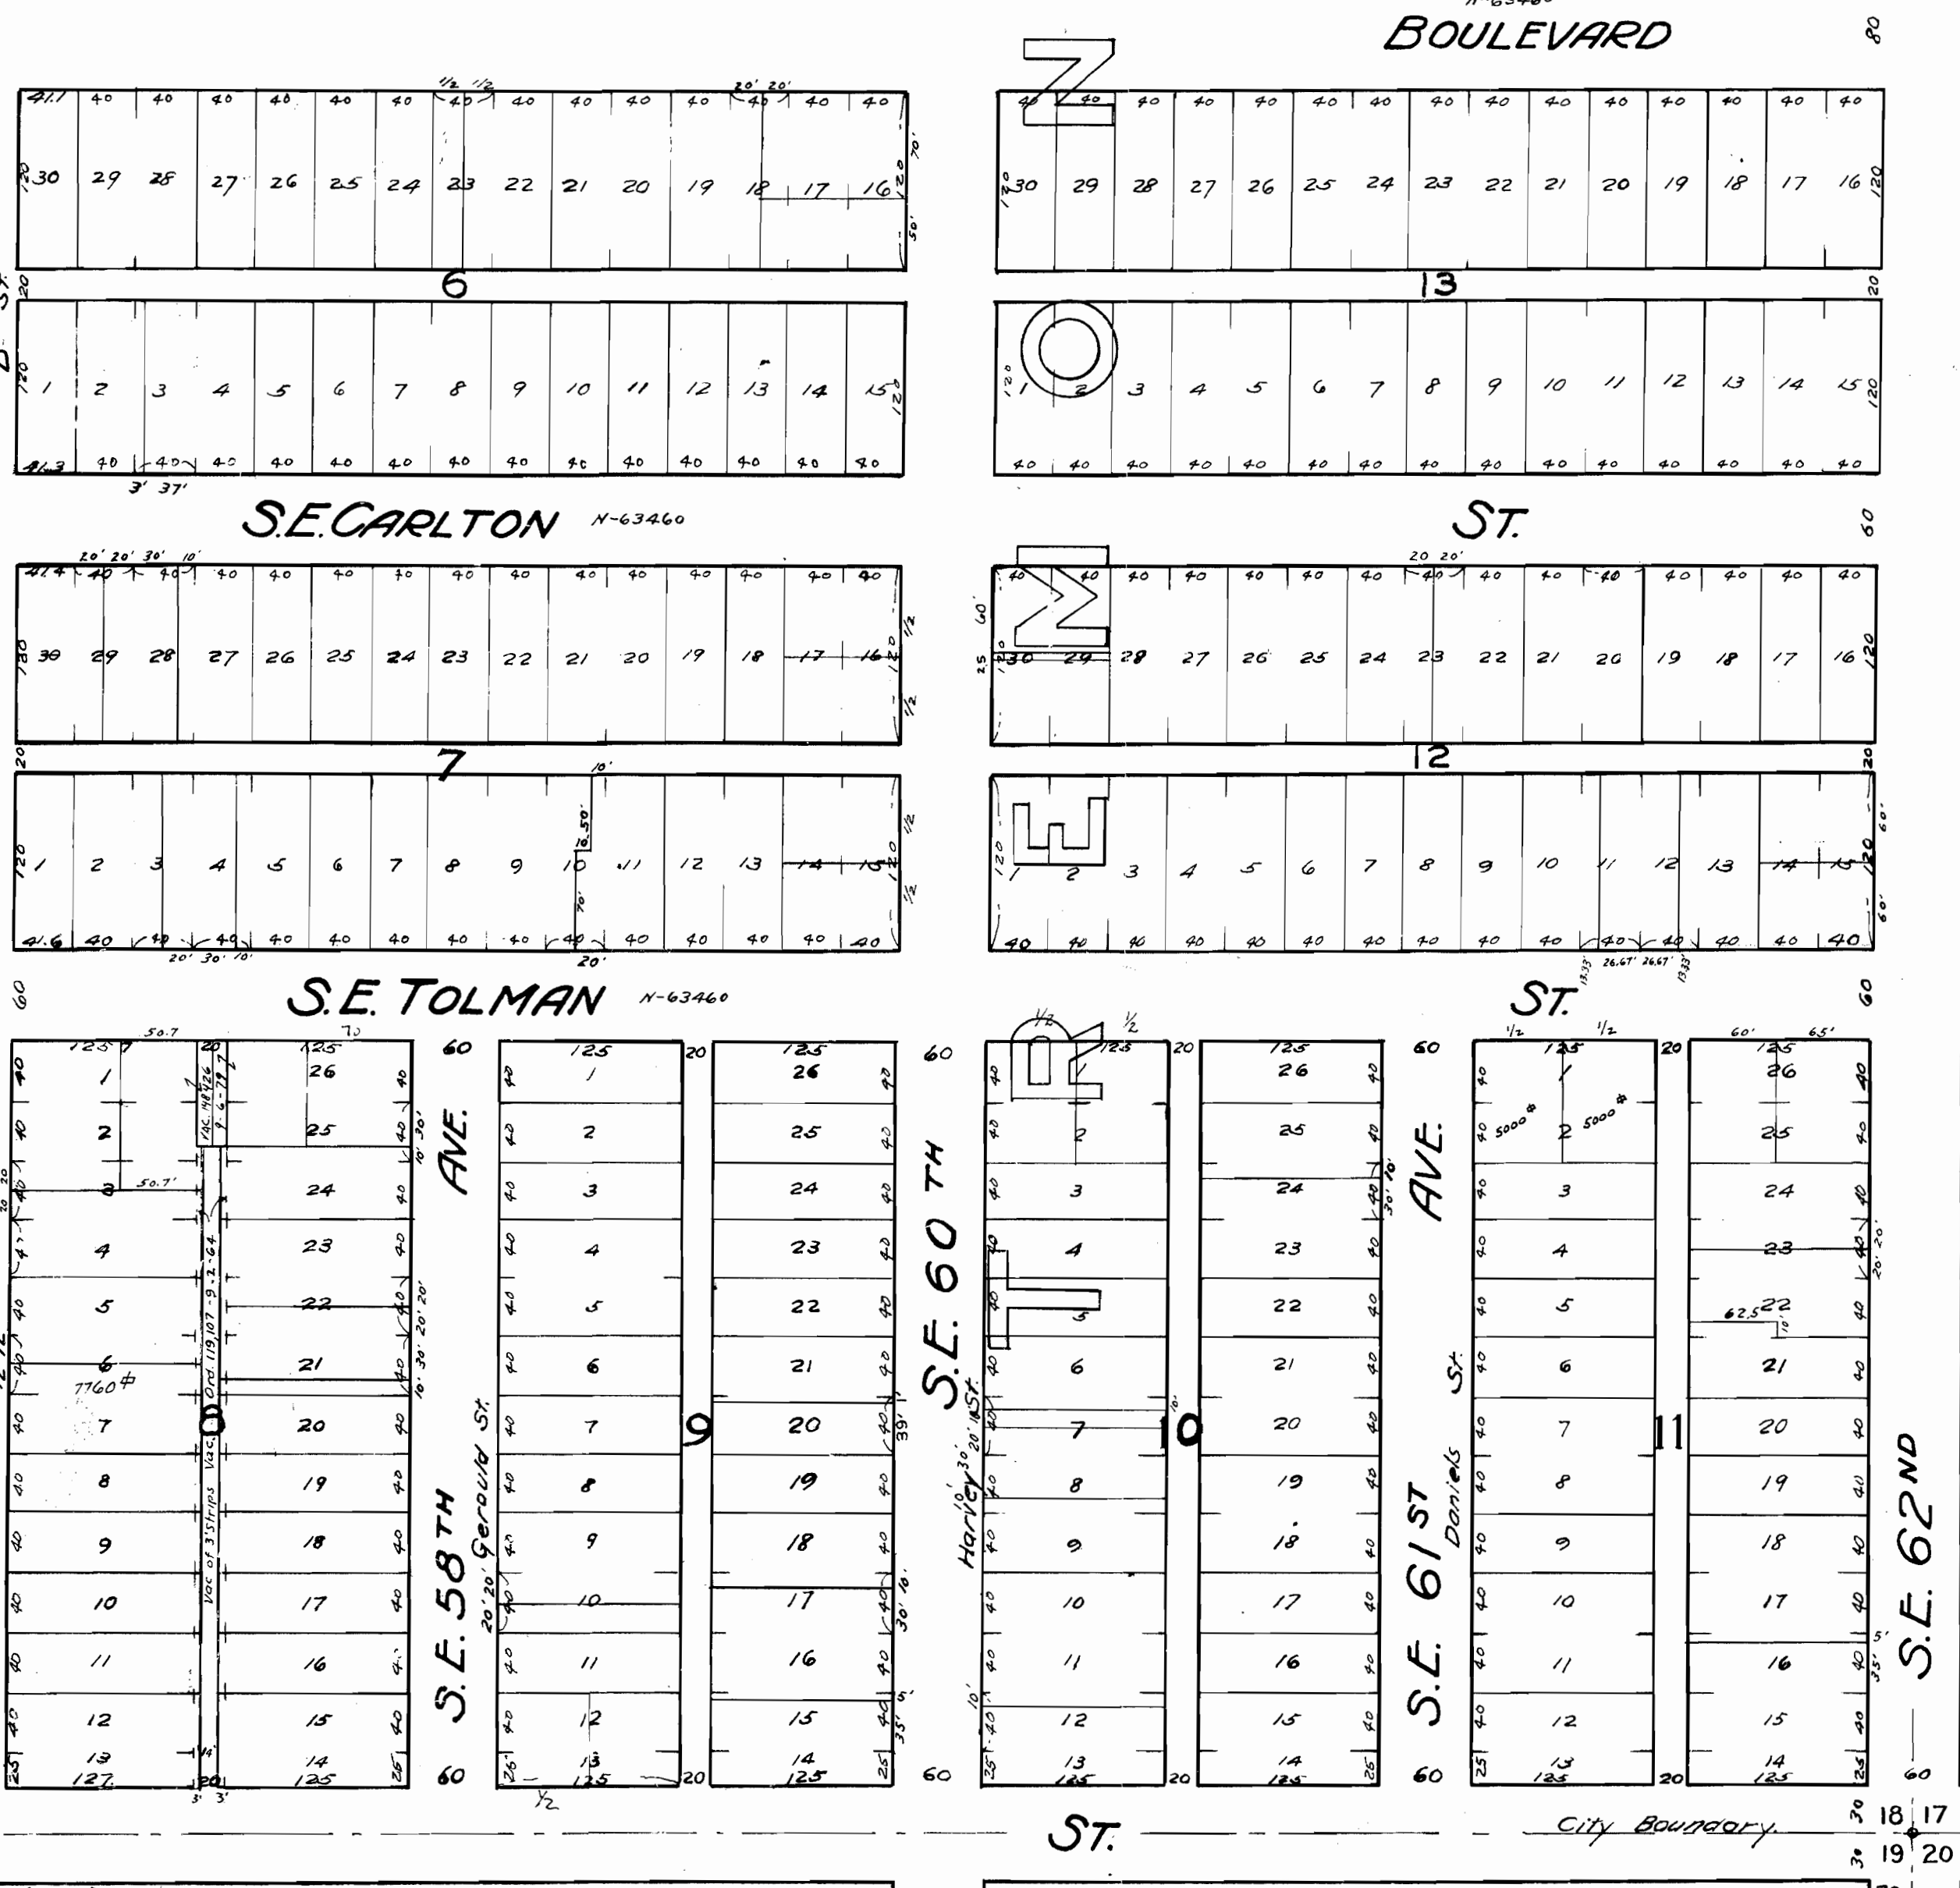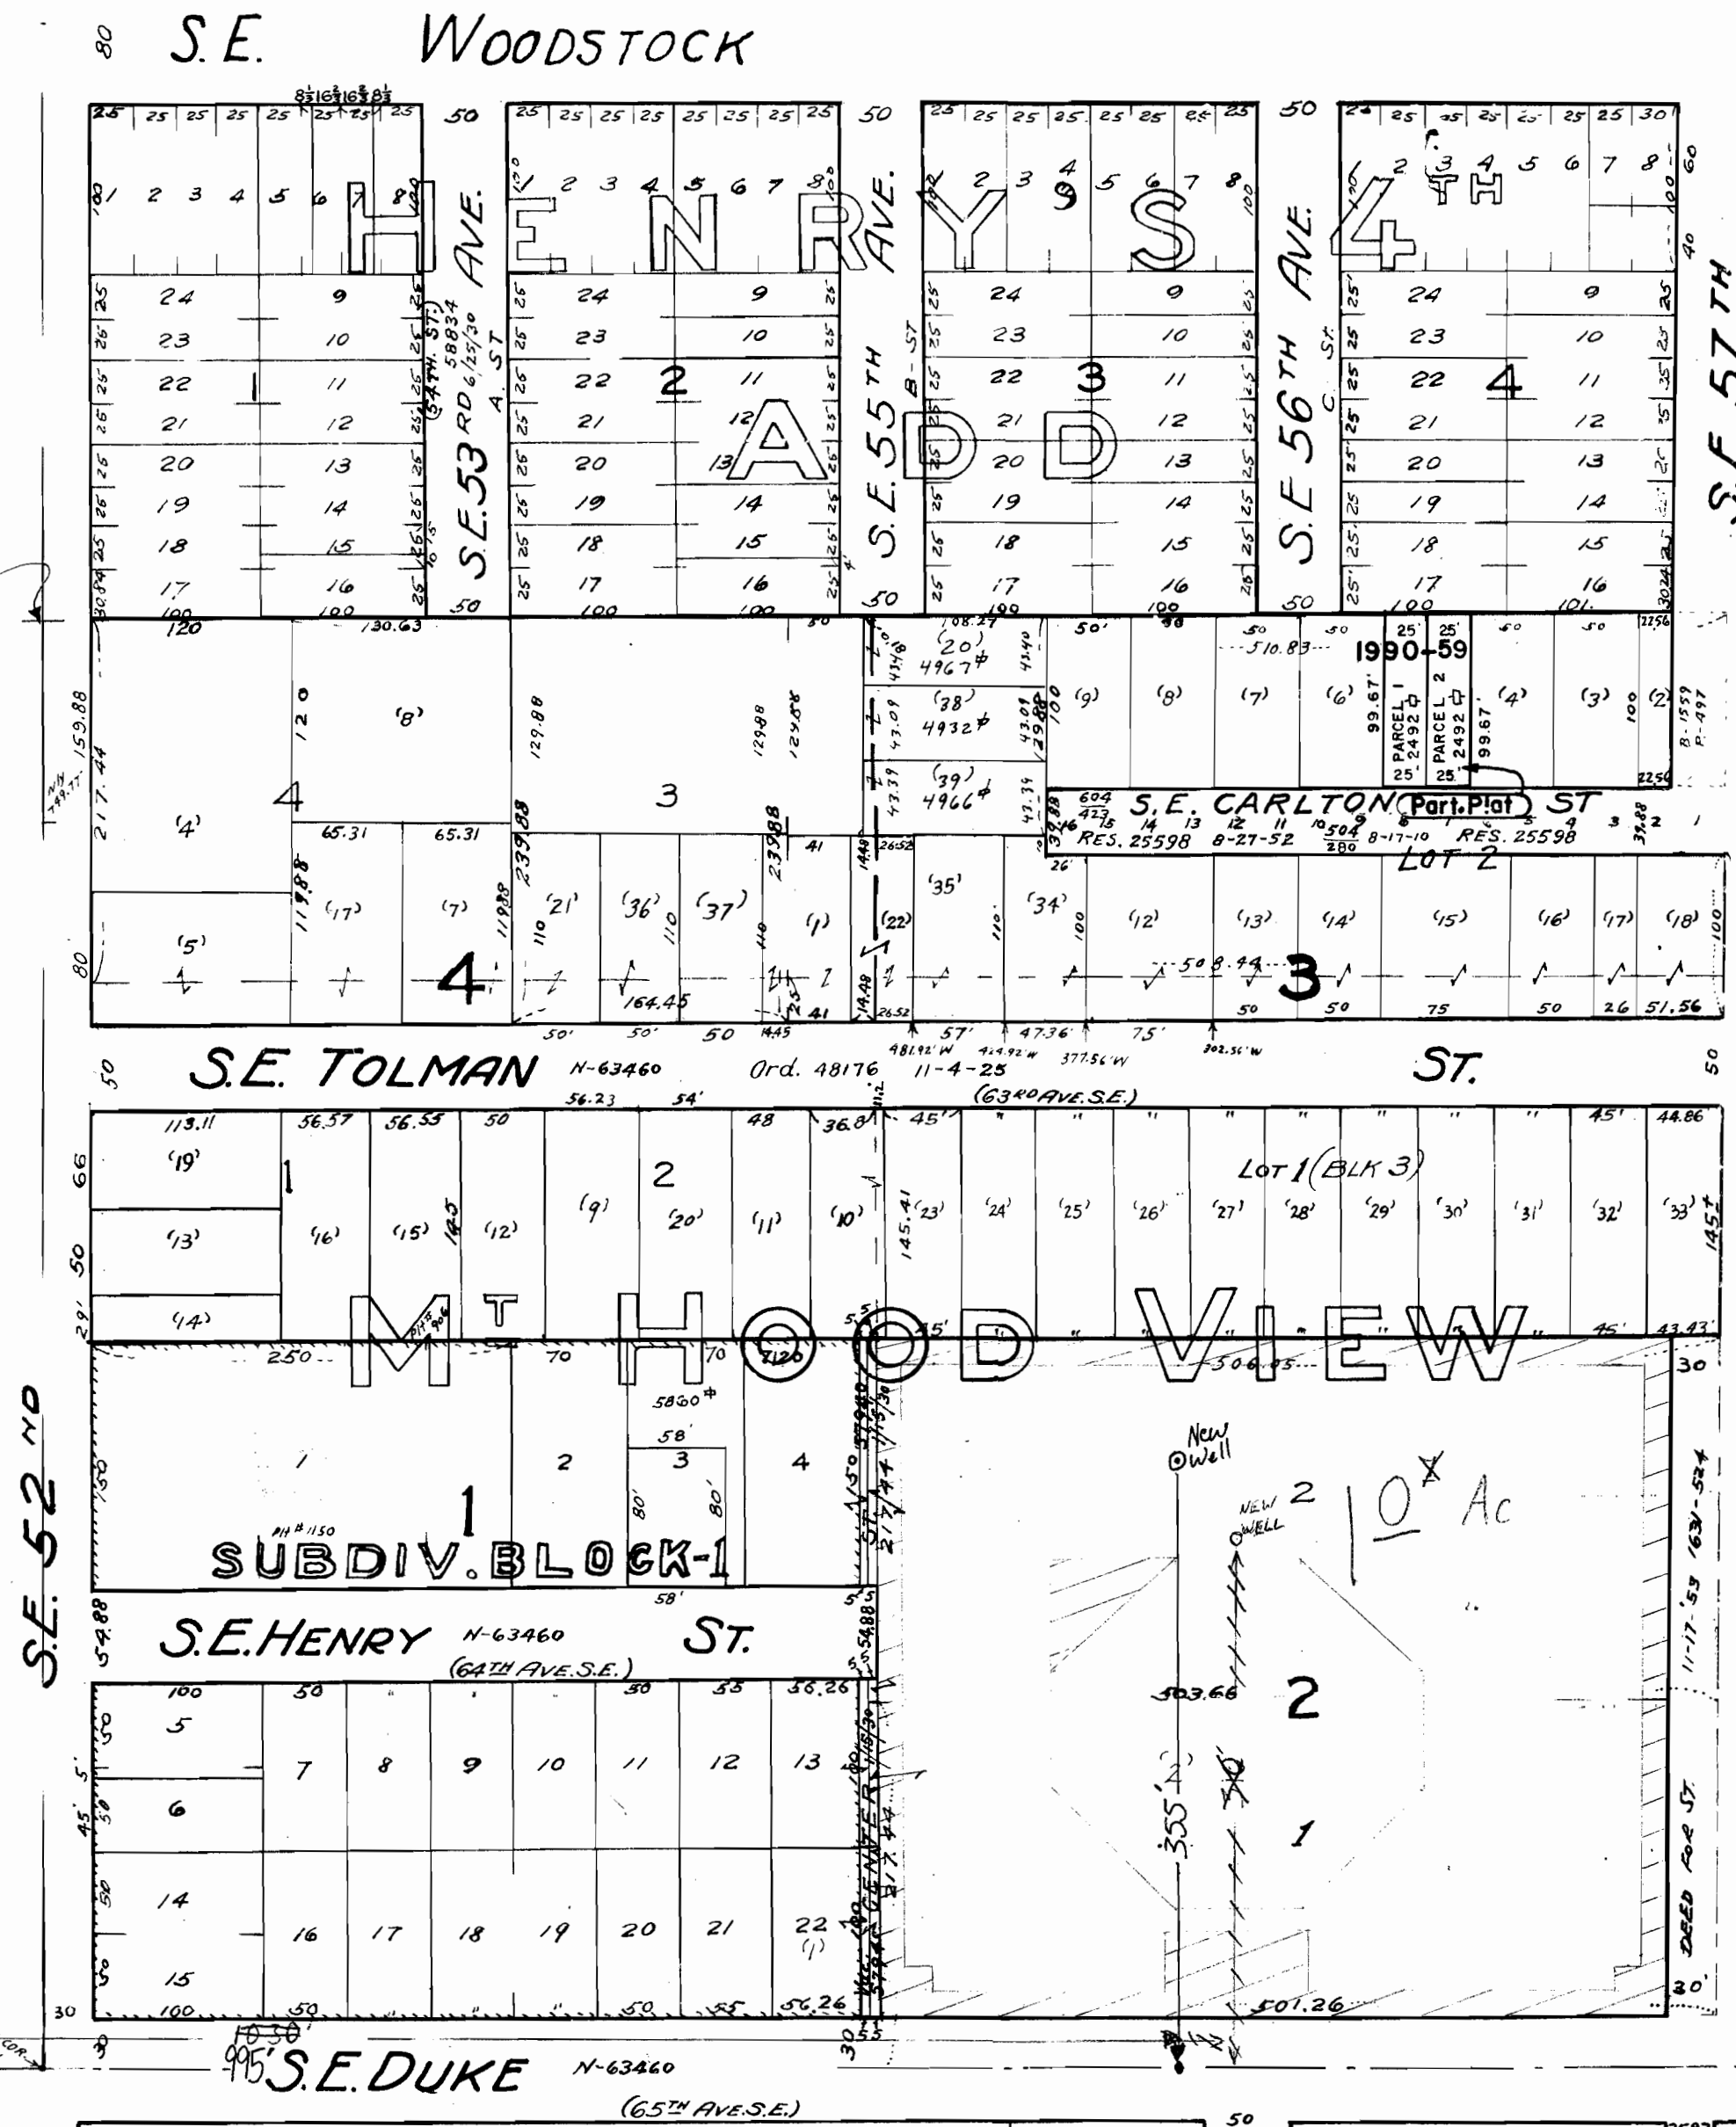

GILTNER-WHITE PK.

3736

600-31

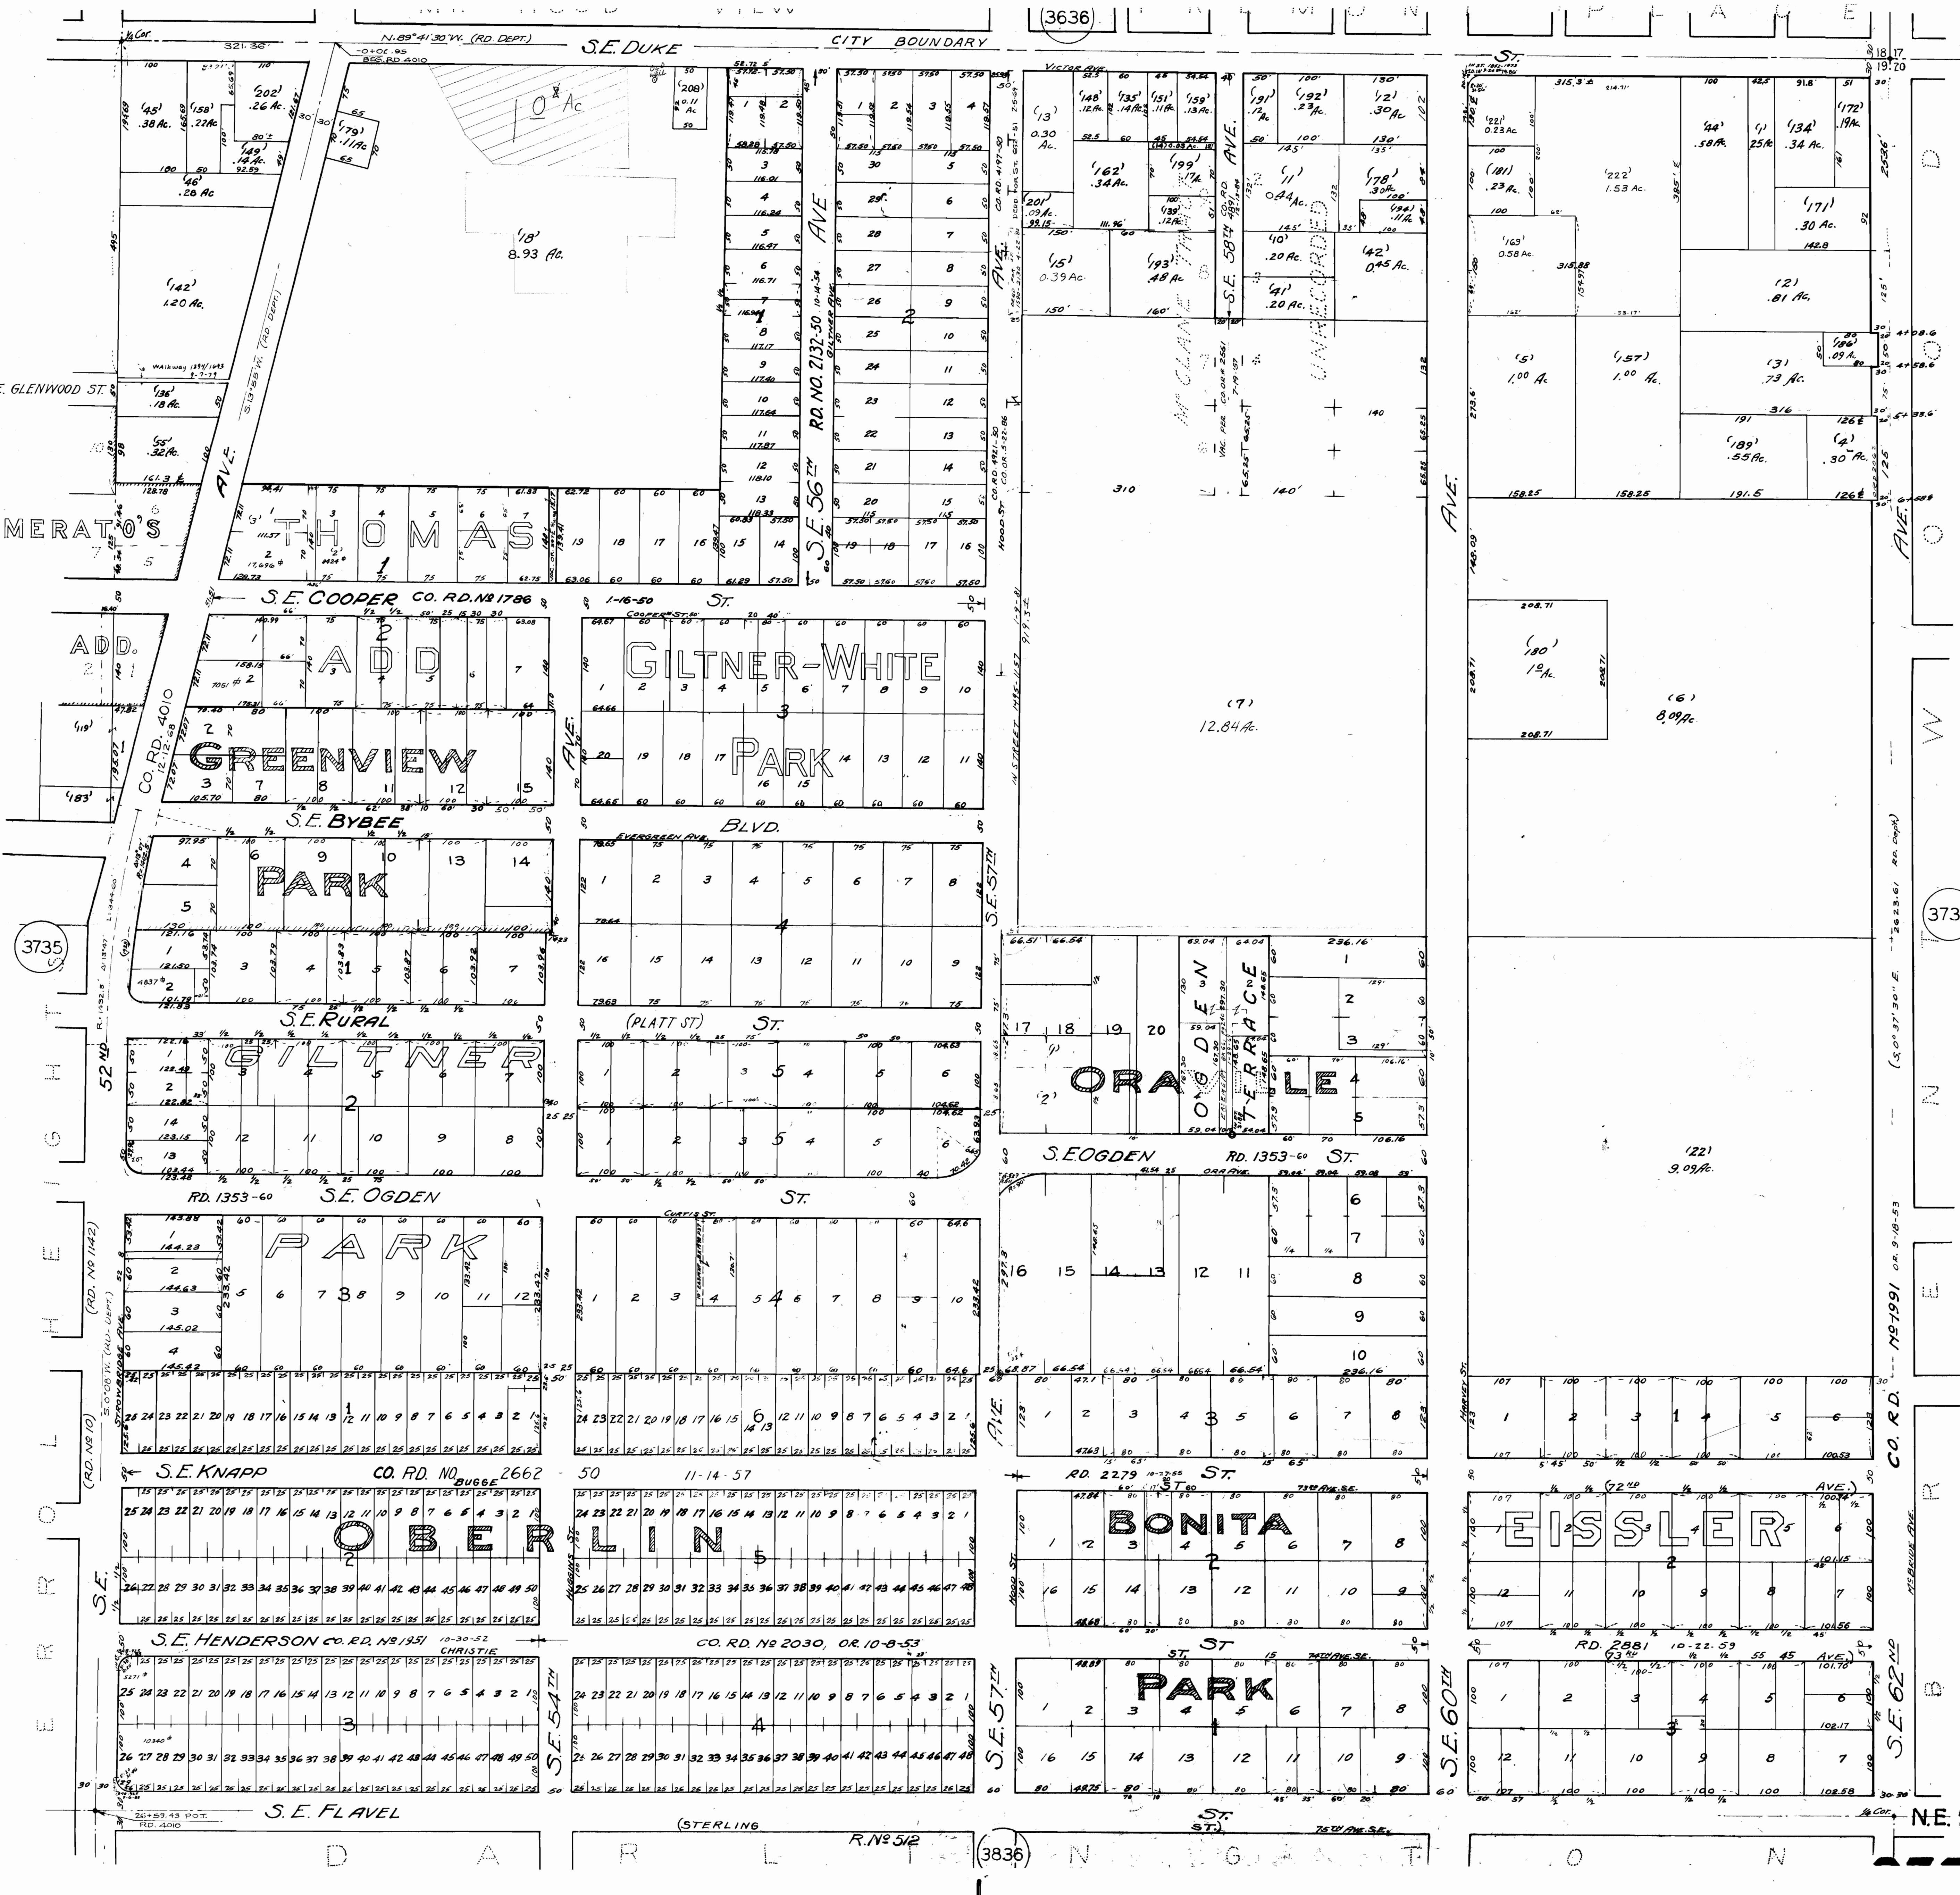

3735

3737