


T. 2 N., R. 1 W., W.M.

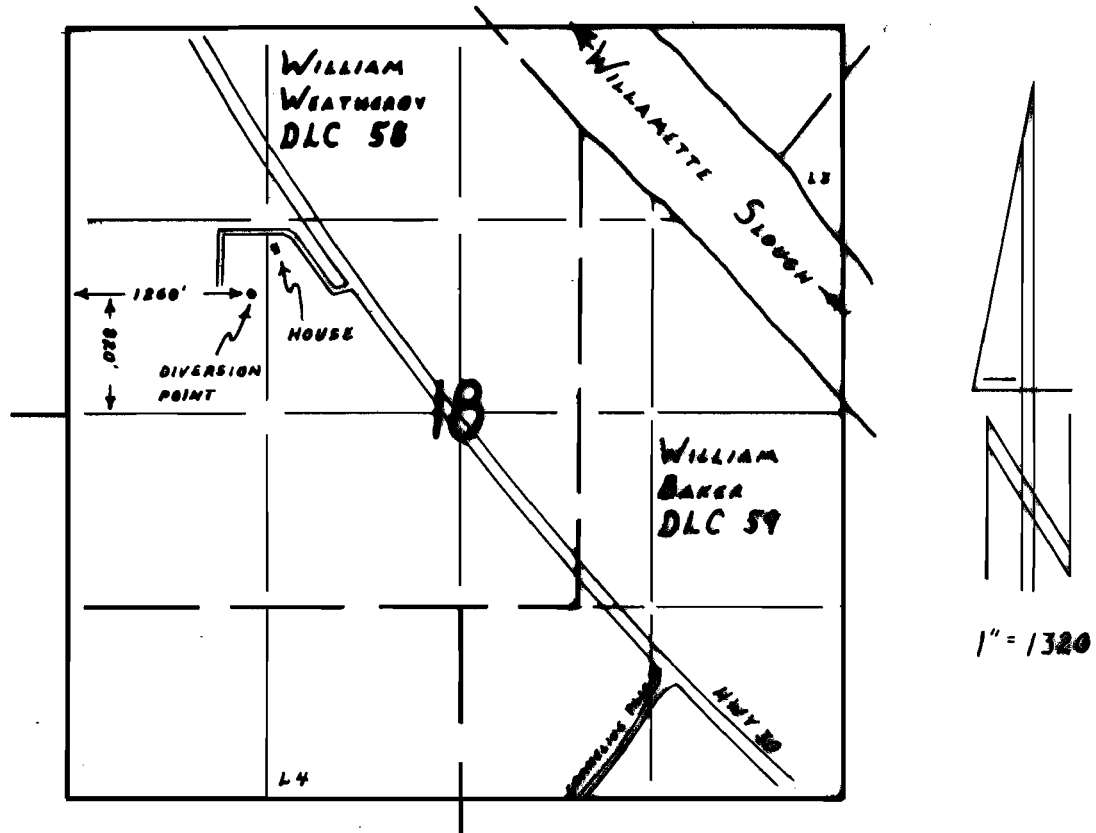

FINAL PROOF SURVEY

UNDER

Application No. 68548 Permit No. 49479
IN NAME OF

David Fredrick Weich, Sr.

Surveyed July 7, 1993, by R.W. Klassen