


T.1&2S.R.1E.W.M.

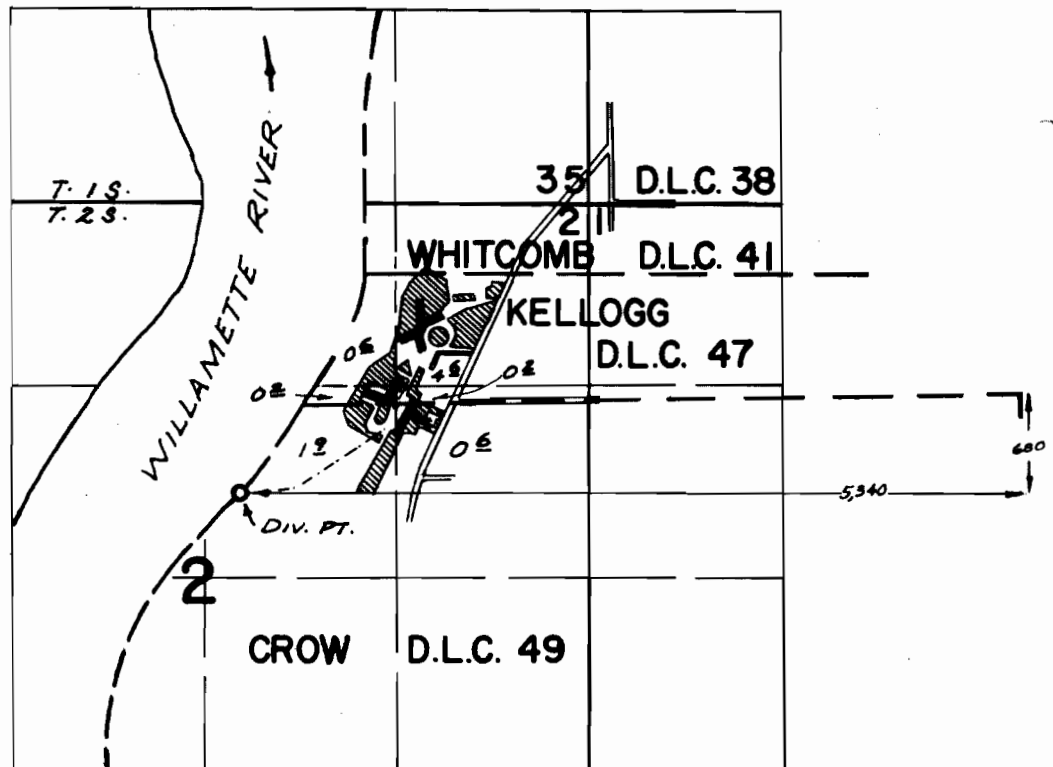

FINAL PROOF SURVEY UNDER

Application No. ~~30079~~..... Permit No. ~~23707~~.....
IN NAME OF

WILLAMETTE VIEW MANOR INC.

Surveyed JUNE 3, 1971, by R. MUCKEN