


T. 8 S., R. 19 E., W.M.

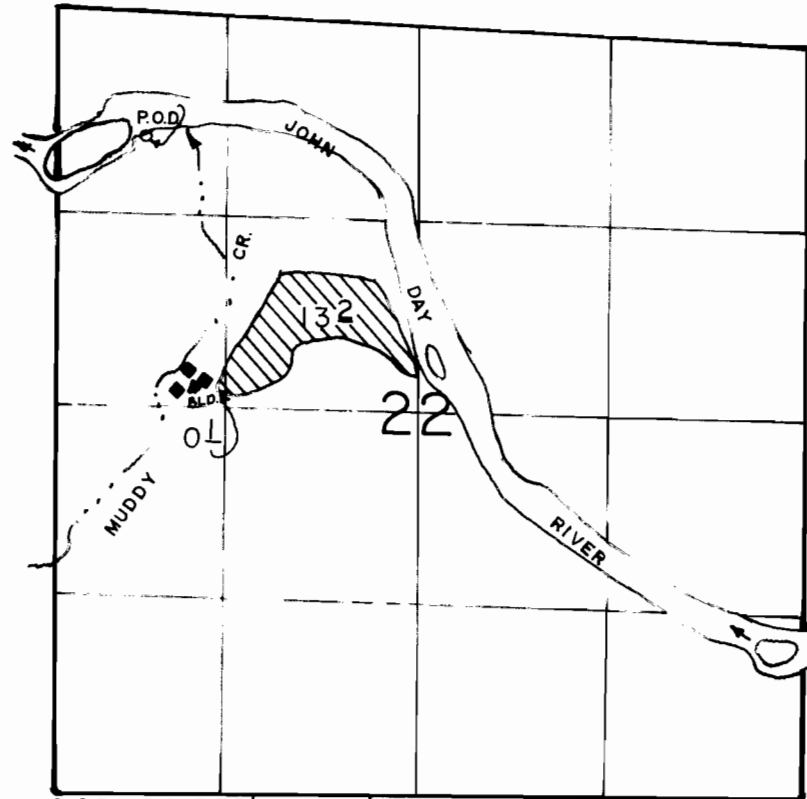

P.O.D. LOC: 850' S & 600' E FROM NW COR. OF SEC 22.

SCALE: 1" = 1320'

FINAL PROOF SURVEY

UNDER

Application No. 63606 Permit No. 46859
IN NAME OF

RAJNEESH NEO-SANNYAS INTERNATIONAL COMMUNE

Surveyed MARCH 20, 1995, by R.M.SUTTERFIELD