


THIS MAP WAS PREPARED FOR THE PURPOSE OF IDENTIFYING THE LOCATION OF THE WATER RIGHT AND IS NOT INTENDED TO PROVIDE LEGAL DIMENSIONS OR LOCATIONS OF PROPERTY OWNERSHIP LINES.

THIS, RIE, W.M.

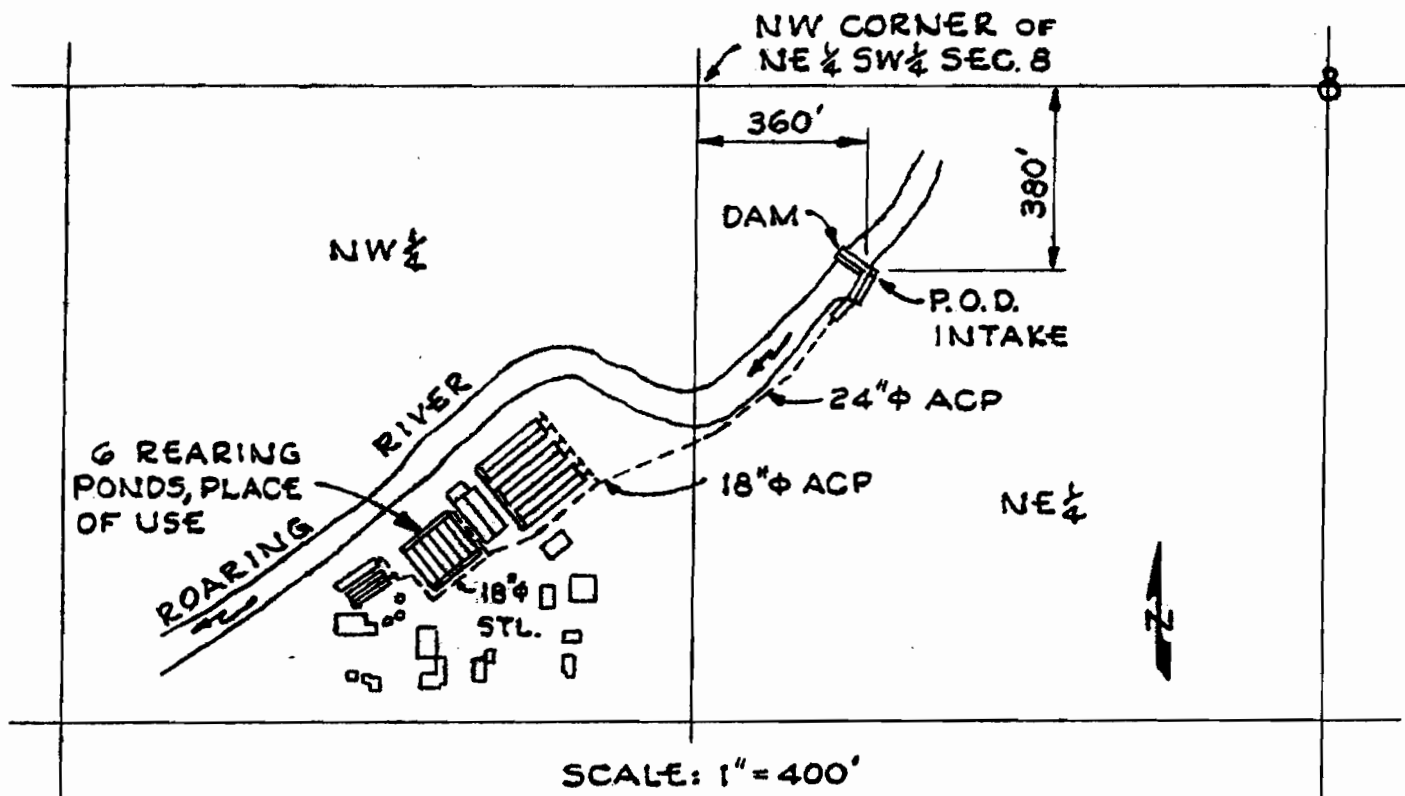

POD LOCATED 380' SOUTH AND 360' EAST OF THE NW CORNER OF NE 1/4 OF SW 1/4 OF SECTION 8.

FINAL PROOF SURVEY

UNDER

APPLICATION NO 71060 PERMIT NO 51219

IN NAME OF

OREGON DEPARTMENT OF FISH AND WILDLIFE

SURVEYED JUNE 11, 1991

BY DODGE

