


T.3S. R.2&3W. W.M.

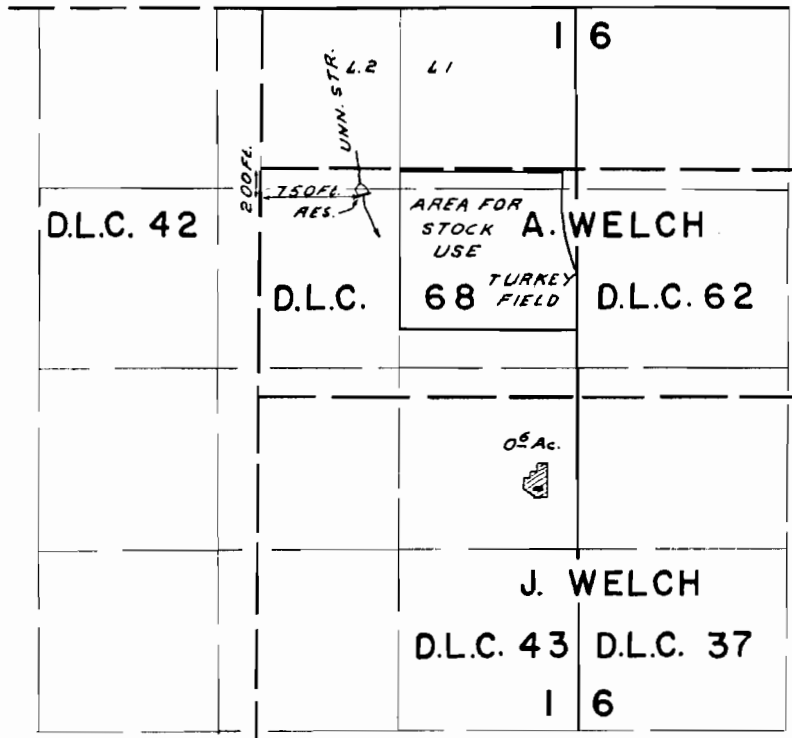

FINAL PROOF SURVEY
UNDER

R - 37059 R-2663

Application No. 37060 Permit No. 27573
IN NAME OF

RALPH E. JOHNSON

Surveyed AUG 19 1965, by L. COLEBANK