

FINAL PROOF SURVEY

for JAMES SNEJKAL

in the NW1/4 SW1/4, SEC 4,


TWP 2N, RGE 4W, W.M.

WASHINGTON COUNTY, OREGON

SCALE 1" = 400'

MARCH 21, 1991

PERMIT # 50433 , R-11009

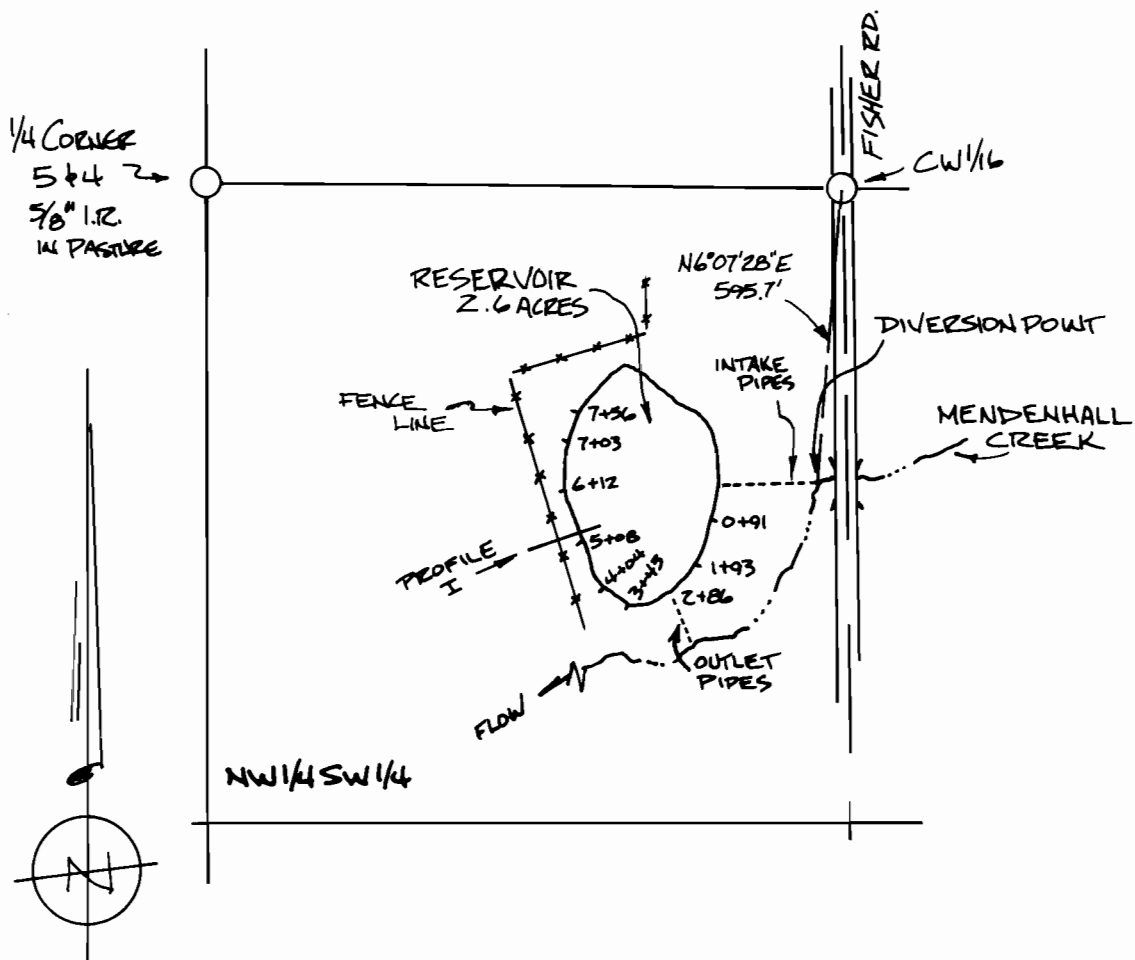

FINAL PROOF INSPECTION
L. JERRY KEENON
1311 ALDER ST.
VERNONIA, OREGON
97064
CWRE # 227

