

# FINAL PROOF SURVEY

for JAMES SNEJKAL

in the NW 1/4 SW 1/4, SEC 4,


TWP 2N, RGE 4W, W.M.

WASHINGTON COUNTY, OREGON

SCALE 1" = 400'

MARCH 21, 1991

PERMIT # 50433 , R-11009

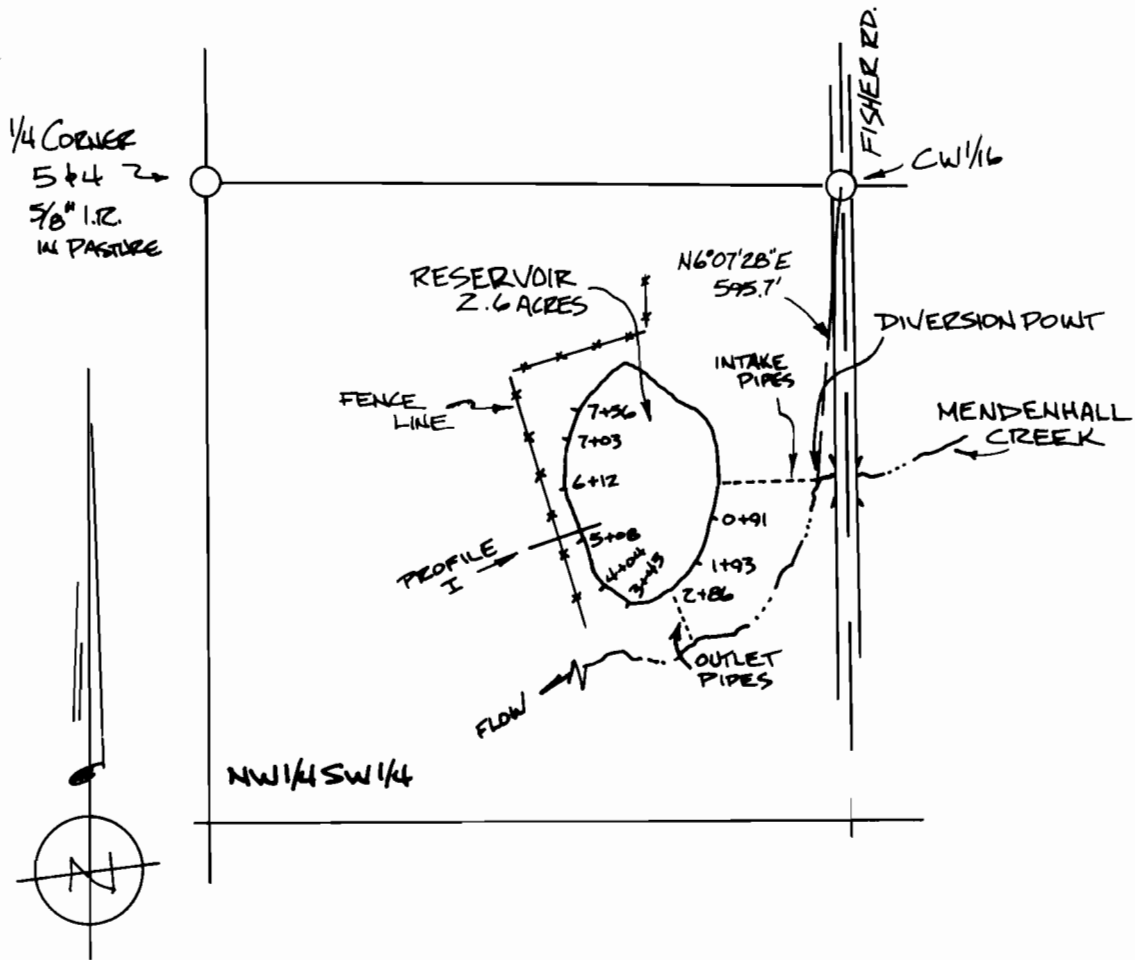

FINAL PROOF INSPECTION

L. JERRY KEENON

1311 ALDER ST.

VERNONIA, OREGON

97064

CWRE # 227

