FINAL PROOF MAP
IN THE NAME OF KENNA CLAY JORDAN

CLAY KENNA JORDAN } AS INCORRECTLY SWITCHED
CLAY JORDAN } ON APLICATIONS.

APPLICATION 60347 PERMIT 47193
APPLICATION R-60346 PERMIT R-8544

NORTH

PROPERTY LOCATION:
DOERNER'S ADDITION
TO EDEN ORCHARDS
NORTH 1/2 OF SE 1/4 SW 1/4 OF SECTION 4
TOWNSHIP 27 SOUTH, RANGE 7 WEST, W.M.
BEING THE NORTH QUARTER OF LOT 26 AND 27
IN THE COUNTY OF DOUGLAS, STATE OF OREGON

THE POINT OF DIVERSION IS LOCATED 895 FEET NORTH AND 310 FEET WEST FROM THE S 1/4 CORNER OF SECTION 4, BEING WITHIN THE SE 1/4 SW 1/4 OF SECTION 4, TOWNSHIP 27 SOUTH, RANGE 7 WEST, WM, IN THE COUNTY OF DOUGLAS. PUMP LOCATION 25 FEET NORTH OF POINT OF DIVERSION.

1"=400'

IRRIGATION
5.35 AC

JORDAN
RESERVOIR
1.102 ACRE-FOOT
STORAGE

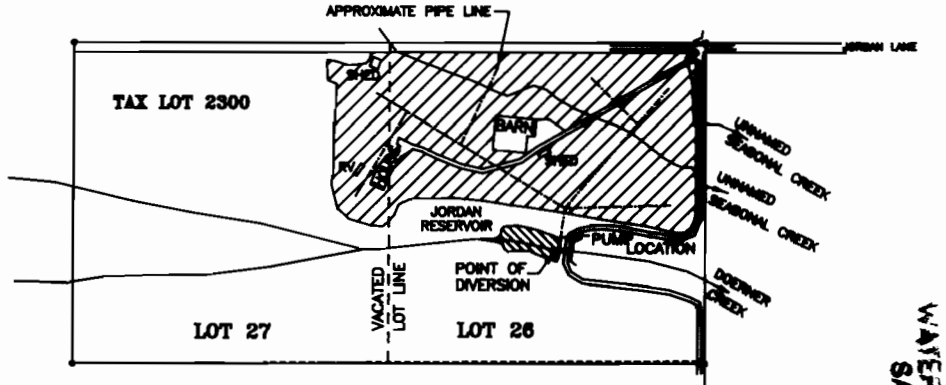

CERTIFIED WATER RIGHTS EXAMINER
431WRE
KENNA CLAY JORDAN
5-14-96
STATE OF OREGON

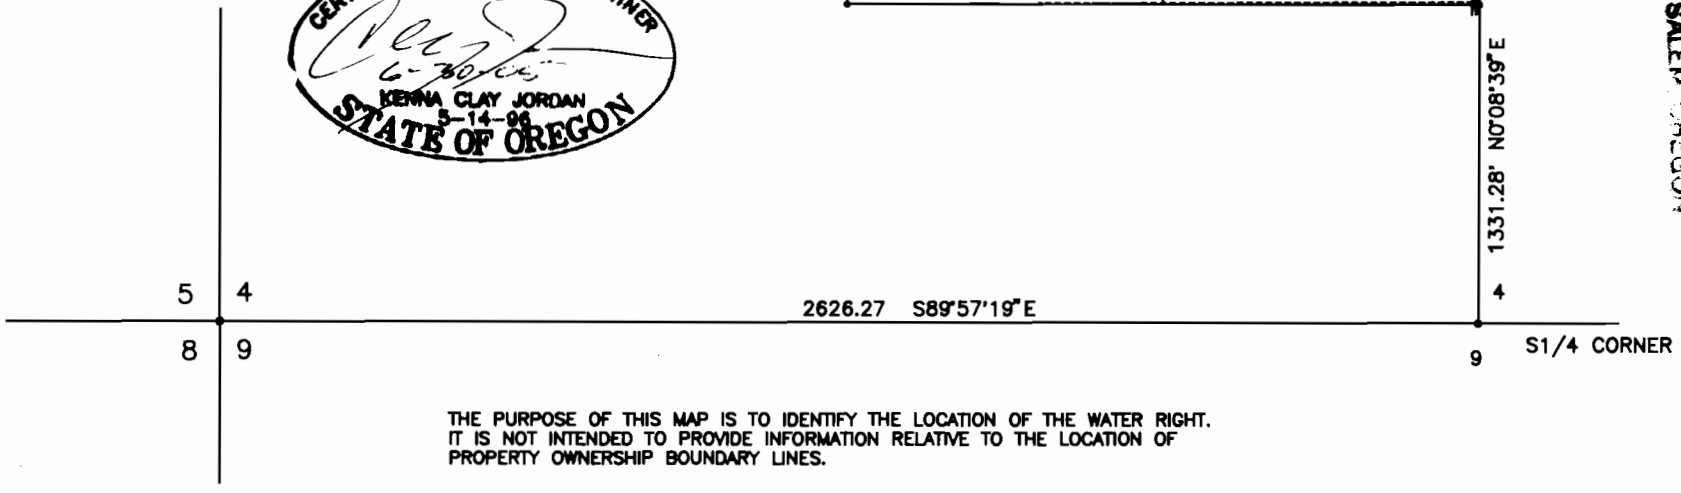

THE PURPOSE OF THIS MAP IS TO IDENTIFY THE LOCATION OF THE WATER RIGHT. IT IS NOT INTENDED TO PROVIDE INFORMATION RELATIVE TO THE LOCATION OF PROPERTY OWNERSHIP BOUNDARY LINES.

RECEIVED
JUN 30 2005
WATER RESOURCES DEPT.
SALEM, OREGON