
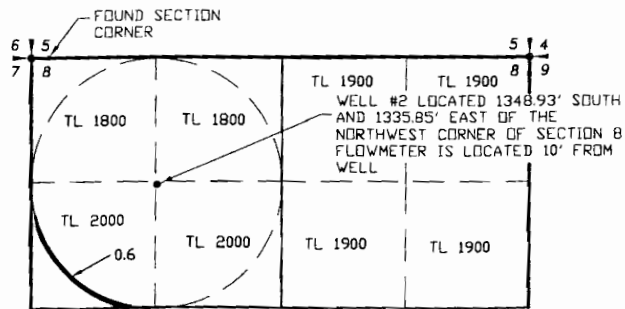


CLAIM OF BENEFICIAL USE MAP

FOR
DAVID & RITA HOGAN

SECTION 23, TOWNSHIP 26 SOUTH RANGE 16 EAST,
SECTION 8, TOWNSHIP 27 SOUTH RANGE 17 EAST,
LAKE COUNTY, OREGON

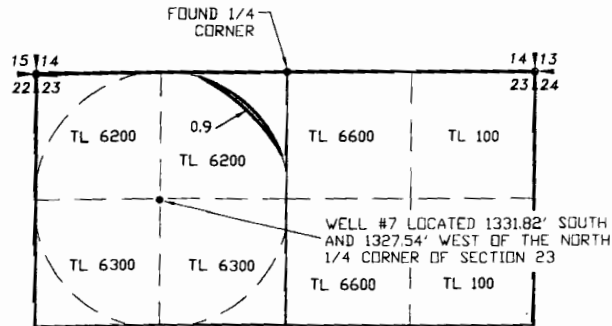

SCALE: 1"=1320'

LEGEND

- SECTION LINE
- 1/4 SECTION LINE
- 1/16 SECTION LINE
- IRRIGATED AREA

RECEIVED

JUN 11 2007

WATER RESOURCES DEPT.
SALEM, OREGON

TRANSFER NO. T-6864

NOTE:
PREPARATION OF THIS MAP IS FOR IDENTIFYING PROPOSED
WATER RIGHTS ONLY. IT HAS NO INTENT TO PROVIDE
LOCATIONS OR DIMENSIONS OF PROPERTY BOUNDARIES.

COBU MAP # 0274

REVISION	BY

**ANDERSON ENGINEERING
AND SURVEYING, INC.**
P.O. BOX 28
LANEVIEW, OREGON
97630 (541)
947-4466 FAX
947-2321

FOR:
DAVID & RITA HOGAN
8814 FIRST STREET
TILLAMOOK, OR 97141
(503) 842-4230

CLAIM OF BENEFICIAL USE
TRANSFER NO. T-6864

DATE:	5/9/2007
SCALE:	1"=1320'
DWG. BY:	R.C.
JOB:	6
FILE:	2007-065
SHEET:	1 OF 1