


T. 2 S., R. 3 E., W.M.

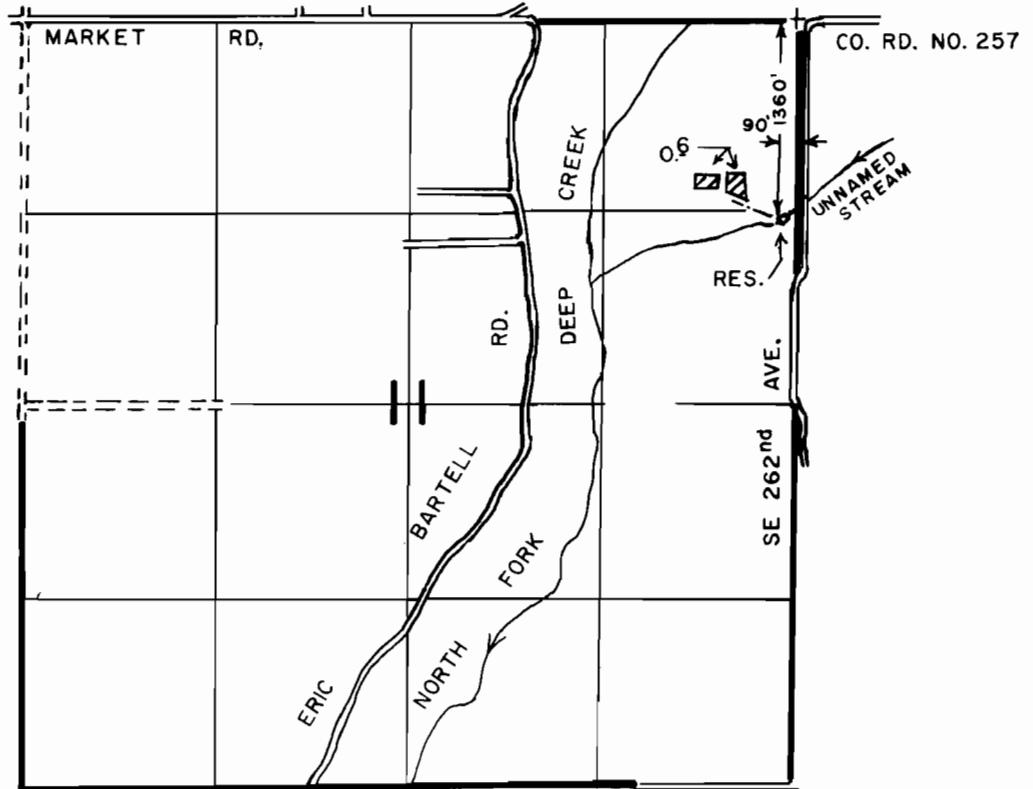

1" = 1320'

FINAL PROOF SURVEY UNDER

R-64942 R-8671
Application No. 64943 Permit No. 47490
IN NAME OF

JOHN GRIFFIN

Surveyed MAY 17 1990, by T.M. WARREN