


T.5S. R.1E. Section 34



EXPIRATION DATE: 6/30/05

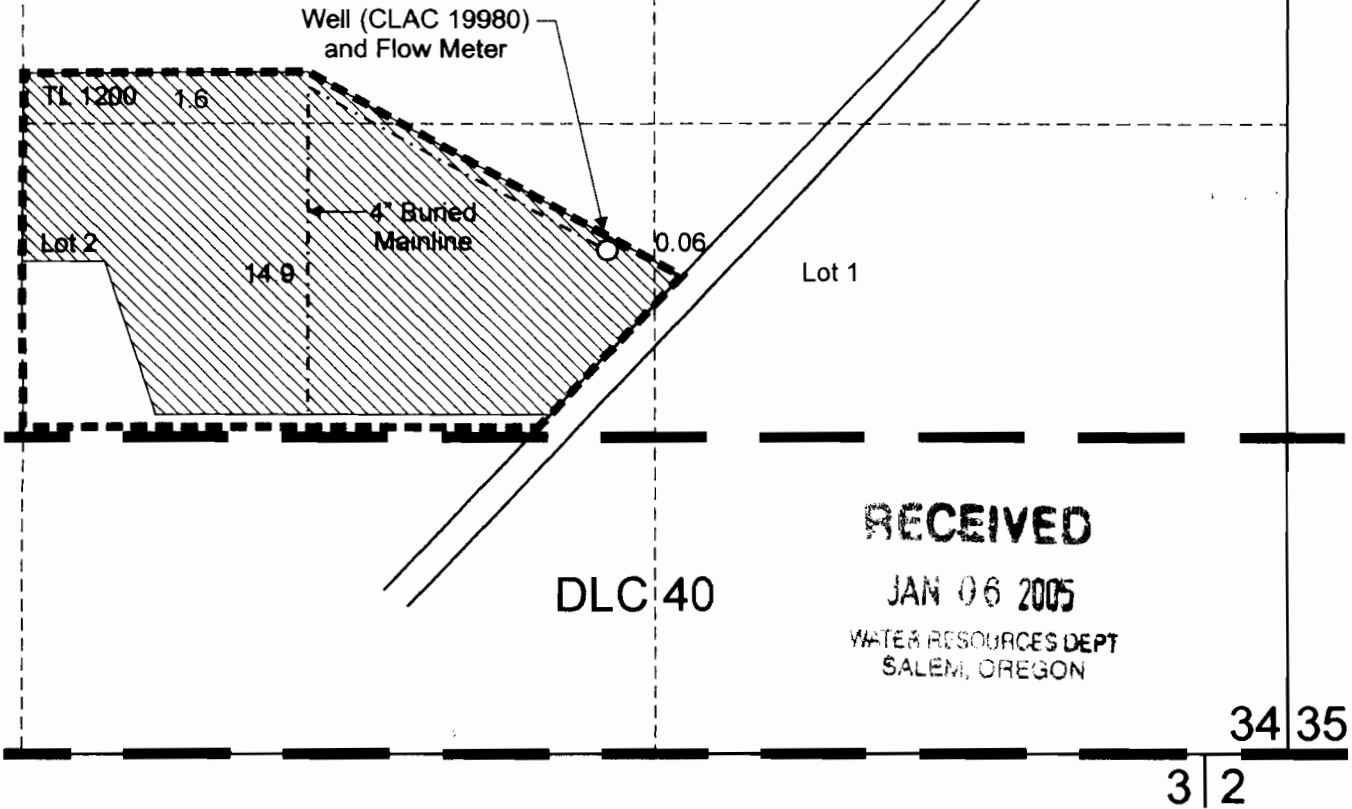


Well (CLAC 19980) is located 1,060 feet north and 1,420 feet west from the SE corner of Section 34.

Area (16.5 Acres) irrigated under Application G-14126, Permit G-13038.

Tax Lot Boundary

Scale: 1" = 400'

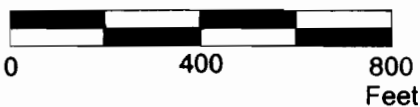

This map was prepared for the purpose of identifying the location of a water right only and is not intended to provide legal dimensions or location of property ownership lines.



Claim of Beneficial Use Map

Peter and Barbara Efimov
T.5S. R.1E. Section 34, Tax Lot 1200

Pacific Hydro-Geology Inc.

1/2005