

SECTION 3 T. 41 S. R. 8 W. W.M. Book 21  
JOSEPHINE COUNTY  
Scale: 1" = 400'

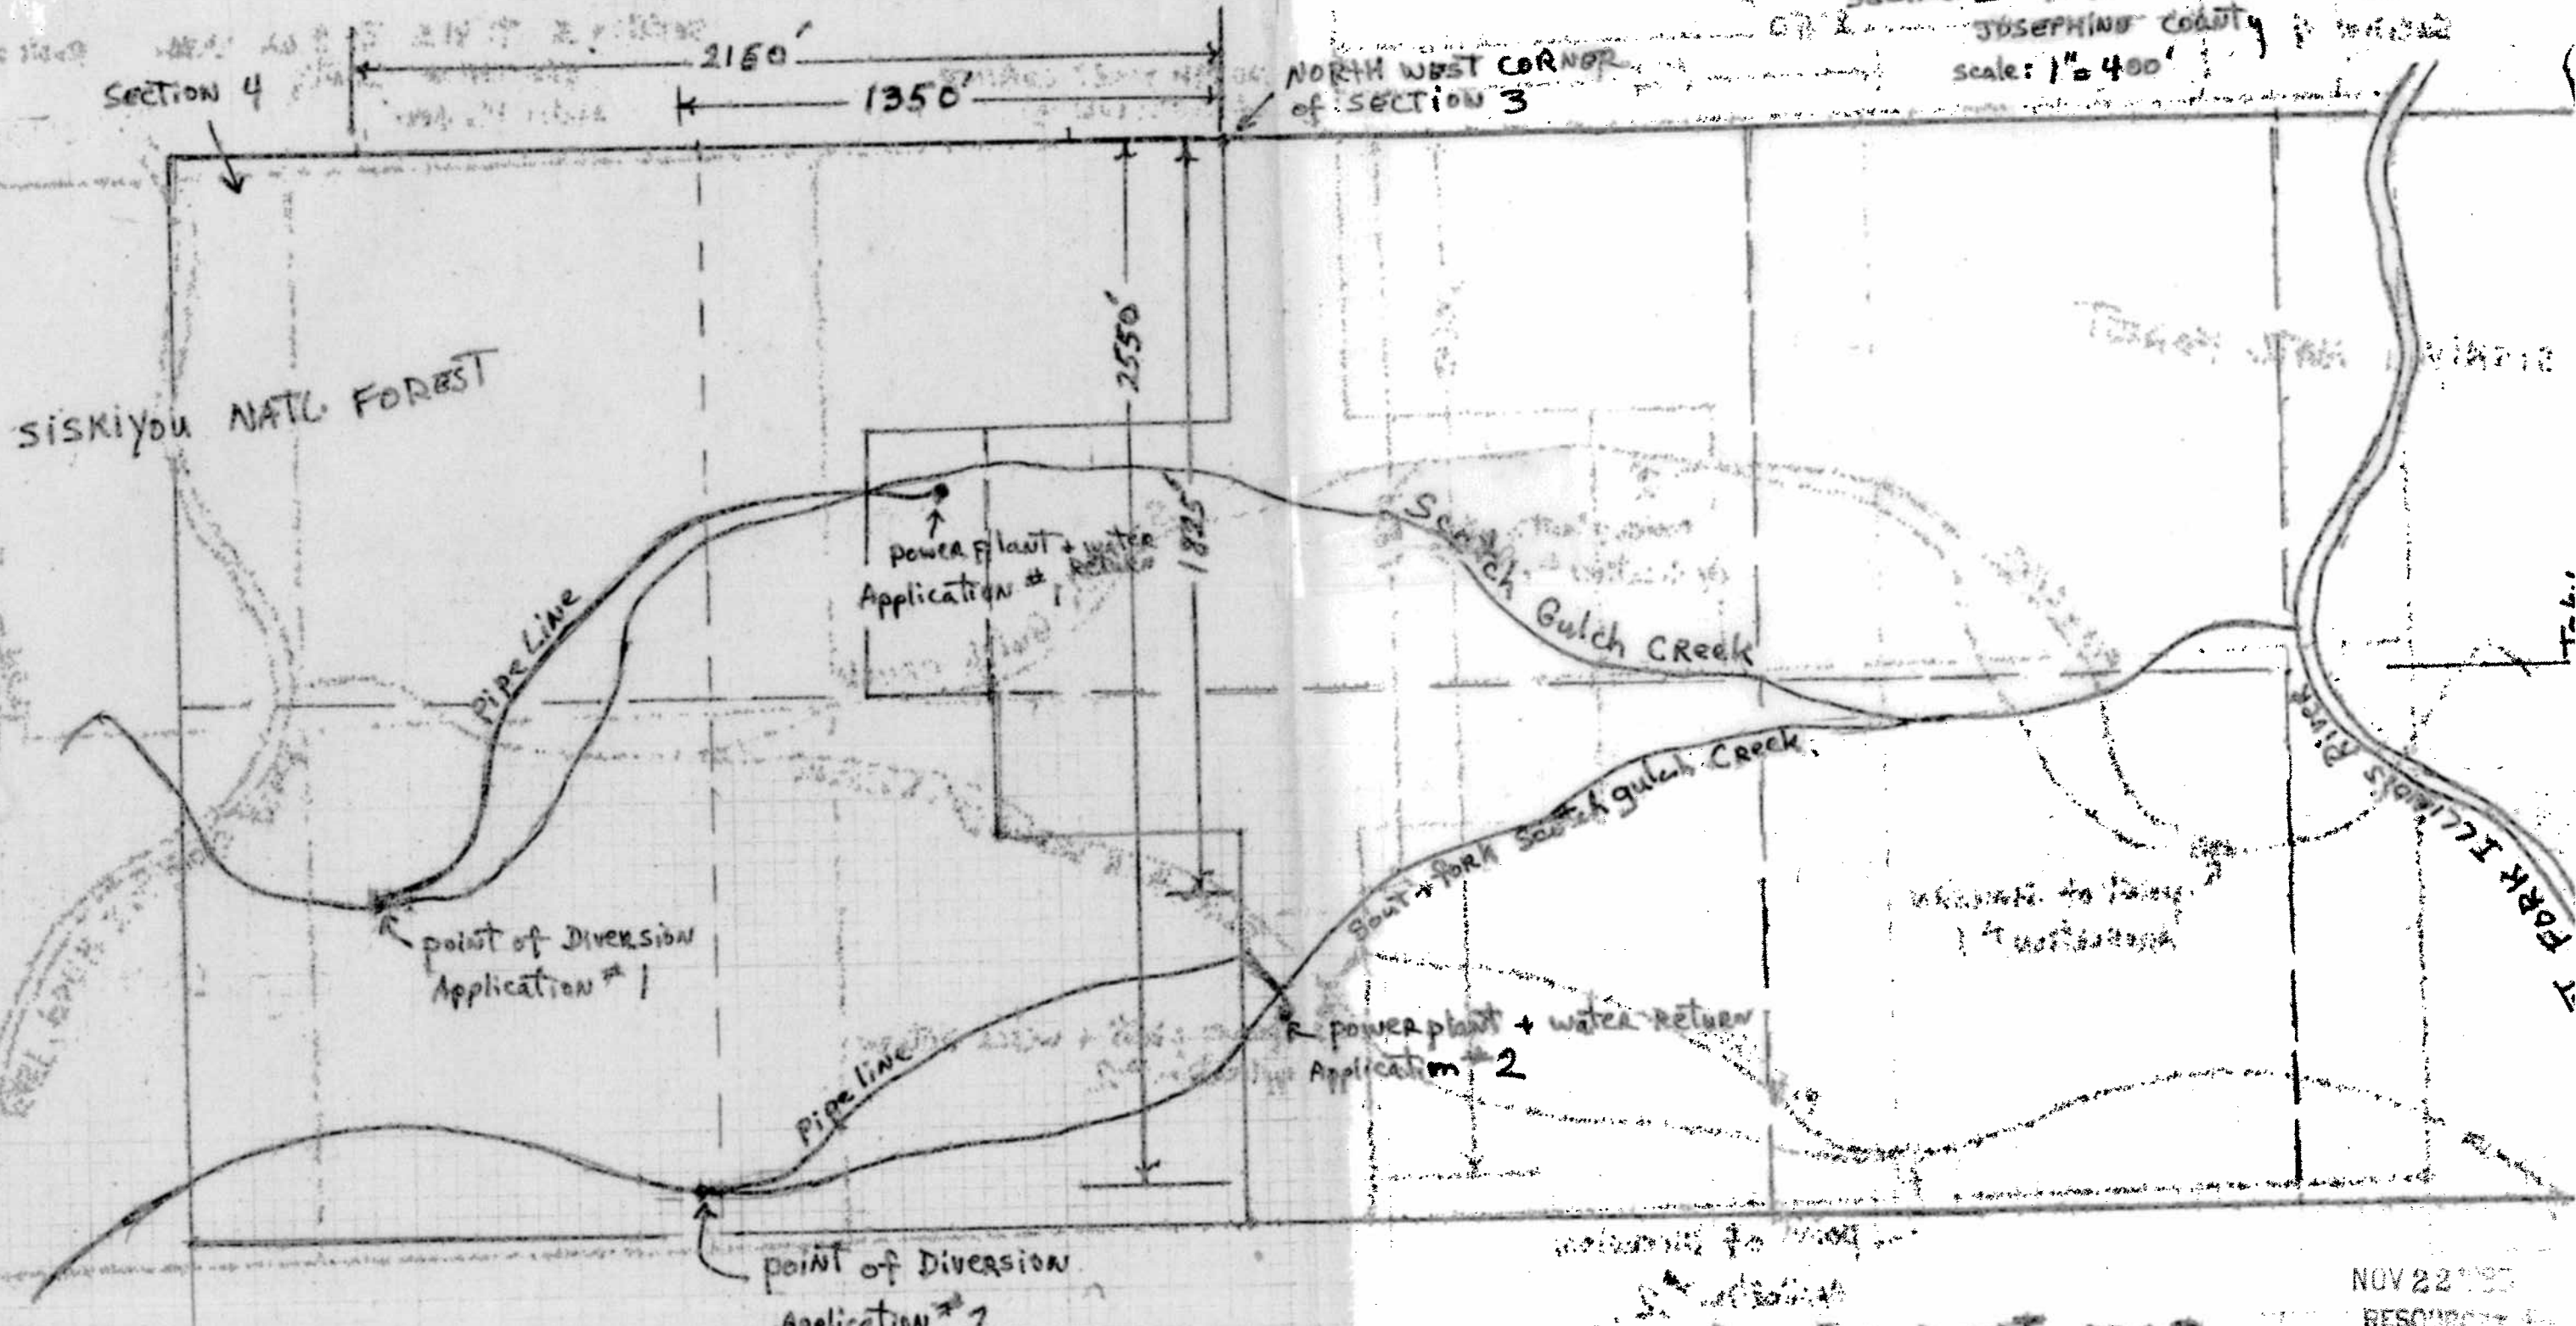


EXHIBIT A PROJECT MAP

FOR APPLICATION #1

NOV 22 1995  
RESOURCES  
OR