


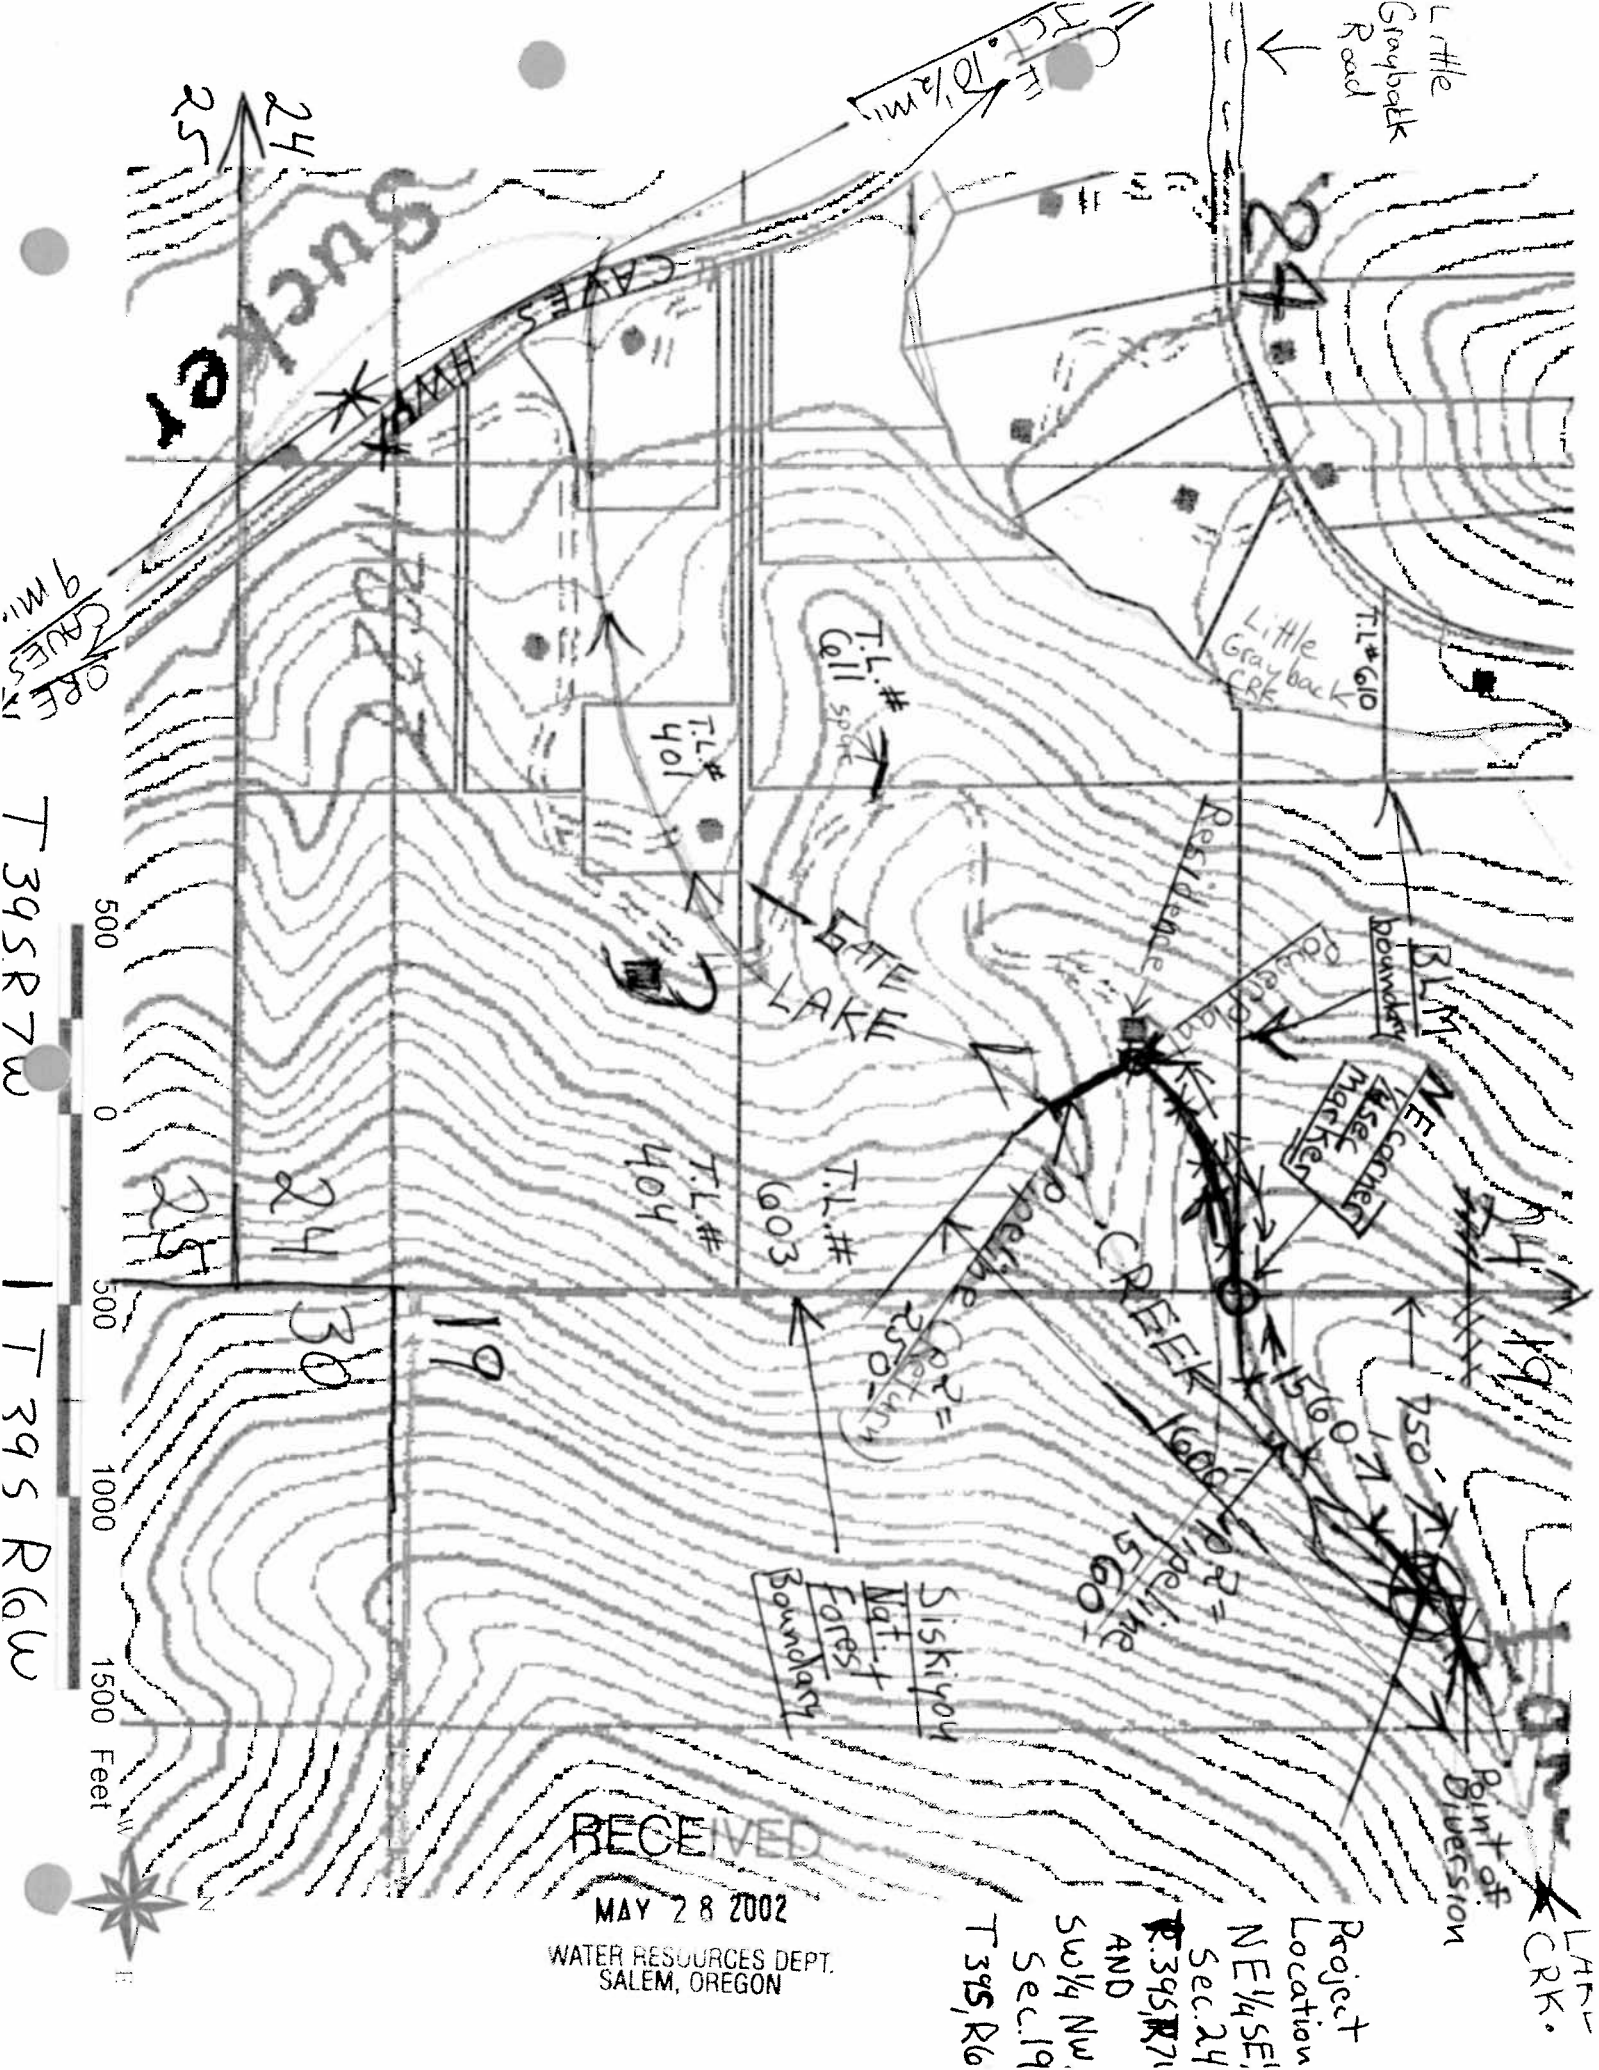

T 39 S R 7 W | T 39 S R 6 W

RECEIVED
MAY 28 2002
WATER RESOURCES DEPT.
SALEM, OREGON

Project Location
NE 1/4 SE 1/4
Sec. 24
T 39 S R 7 W
AND
SW 1/4 NW 1/4
Sec. 19
T 39 S R 6 W

Point of Diversion
CRK.