

SECTION 4, T. 3 S., R. 1 E., W.M.

S. W. 1/4 N. E. 1/4

Section 4

N. E. 1/4 S. W. 1/4

Section 4

N. W. 1/4 S. E. 1/4

Section 4

House

Buried Mainline

Barn

Well

Transmission Tower

WELL IS LOCATED 1290 FEET NORTH AND 65 FEET EAST OF THE SOUTH 1/4 CORNER OF SECTION 4.

S. E. 1/4 S. W. 1/4

Section 4

S. W. 1/4 S. E. 1/4

Section 4

- Area in S.W. 1/4 N.E. 1/4 = 0.9 Acres
- Area in N.W. 1/4 S.E. 1/4 = 12.4 Acres
- Area in S.W. 1/4 S.E. 1/4 = 0.9 Acres
- Area in S.E. 1/4 S.W. 1/4 = 0.6 Acres
- Area in N.E. 1/4 S.W. 1/4 = 3.0 Acres

RECEIVED


MAY 03 1995

WATER RESOURCES DEPT.
SALEM, OREGON



FINAL PROOF MAP
APPLICATION NO. G-12748
PERMIT NO. G-11612
FOR DOUGLAS DAVID

I, DON DEVLAMINCK, CERTIFIED WATER RIGHT EXAMINER IN THE STATE OF OREGON, HEREBY CERTIFY THE ABOVE FINAL PROOF MAP WAS PREPARED UNDER MY DIRECT SUPERVISION.

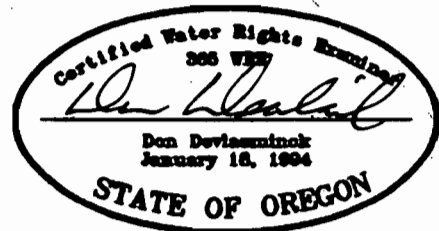

THE PREPARATION OF THIS MAP IS FOR THE PURPOSE OF IDENTIFYING THE LOCATION OF THE WATER RIGHT ONLY AND HAS NO INTENT TO PROVIDE DIMENSIONS OR LOCATIONS OF PROPERTY OWNERSHIP LINES.

Scale: 1" = 400' Date: 4/30/95 Surveyed by: C.V. & T.T. Drawn by: MMM Order No. 2771.2

Compass Corporation

6564 S.E. Lake Road

Milwaukie, Oregon 97222

Phone: (503) 653-9093, 222-4852