


T. 7N., R. 10W., W. M

Section 27

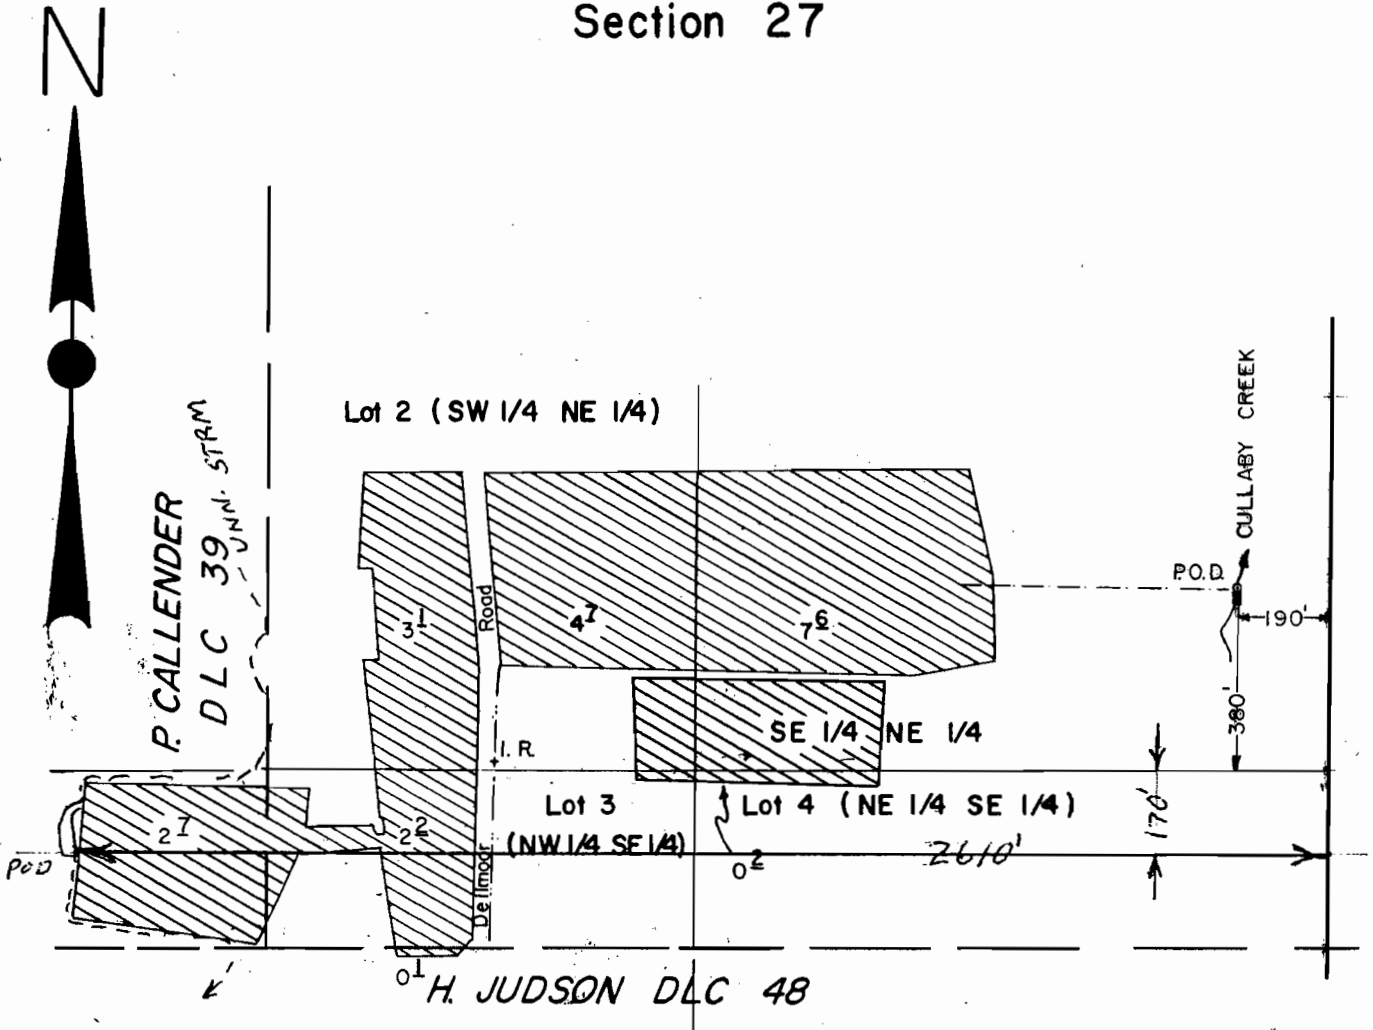

Scale: 1" = 400'

FINAL PROOF SURVEY
UNDER

Application No. 64589, Permit No. 47476.....
IN NAME OF

.....ROBERT B. WHANNELL.....

Surveyed JUNE 21, 1989, by T. WARREN.....

LHM AMENDED 6/21/07
PTS/EF