


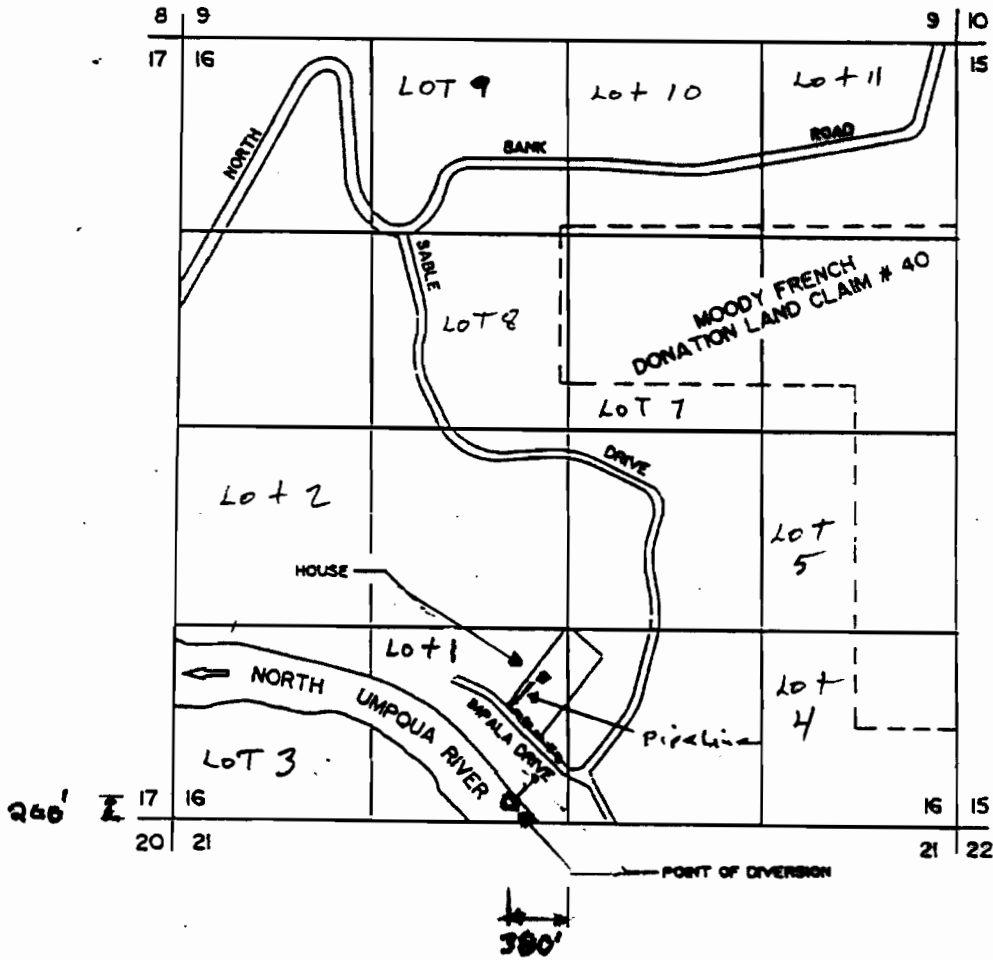

1 INCH = 1320 FEET

CLAIM OF BENEFICIAL USE
 FOR JAMES S. & BARBARA D. LONG
 BY DUANE KIRBY
 T26S, R5W, W.M.
 APPLICATION NO. 72251
 PERMIT NO. 51907



RECEIVED

ALL INFORMATION

WATER RESOURCES DIVISION
SALENO, OR

THE PURPOSE OF THIS MAP IS TO IDENTIFY THE LOCATION OF THE WATER RIGHT. IT IS NOT INTENDED TO PROVIDE INFORMATION RELATIVE TO THE LOCATION OF PROPERTY OWNERSHIP BOUNDARY LINES.

