

?

BETTS

M. DOWELL


SODAVILLE CITY LIMIT

60' EASEMENT

SAND & CHART (SODAVILLE SCHOOL GROUP)

← DLG 5 NEC

JONAS

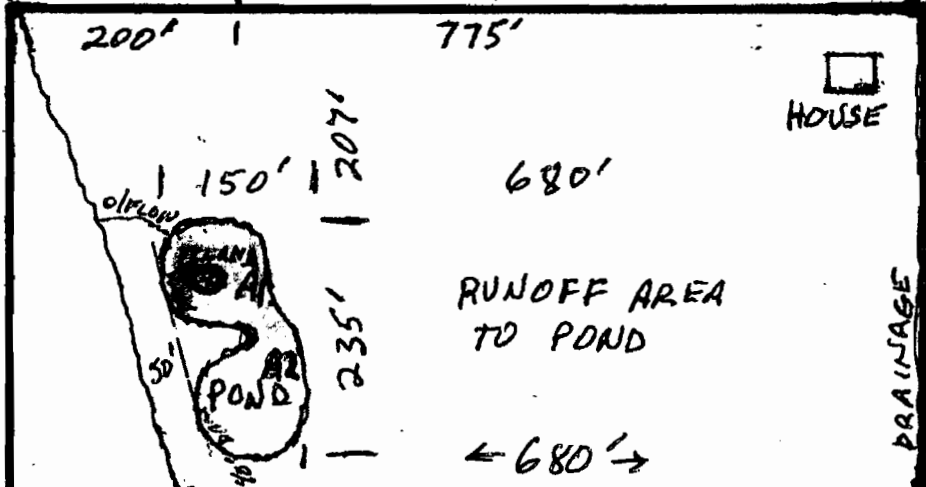

RUNOFF DITCH FROM ROAD (DRAINAGE)

THE ISLAND IS  
 N 860' NORTH &  
 N 1995' WEST  
 OF THE CORNER  
 MARKING SECTIONS  
 30, 31, 6 & 1  
 (BARTELS SURVEY 731-78)

ROS

← N 435' TO 1/4 MARK →

OAK CREEK

S36 T12S R2W  
 S1 T13S R2W

← 1268.4' TO 36' →

2938' TOTAL

TAX LOT 100  
 MAP 13-2W-1  
 ACCT # 0279063  
 61 ACRES  
 CHARLES GOODMAN  
 PROPERTY IN  
 DARK BORDER  
 1 INCH = 200 FEET

30510  
 SODAVILLE -  
 MOUNTAIN HOME  
 ROAD  
 LEBANON, OR  
 97355  
 541-451-1670

SODAVILLE-MOUNTAIN HOME ROAD

RECEIVED

APR 23 2007

WATER RESOURCES DEPT SALEM OREGON