


T.13S. R.14E. W.M.

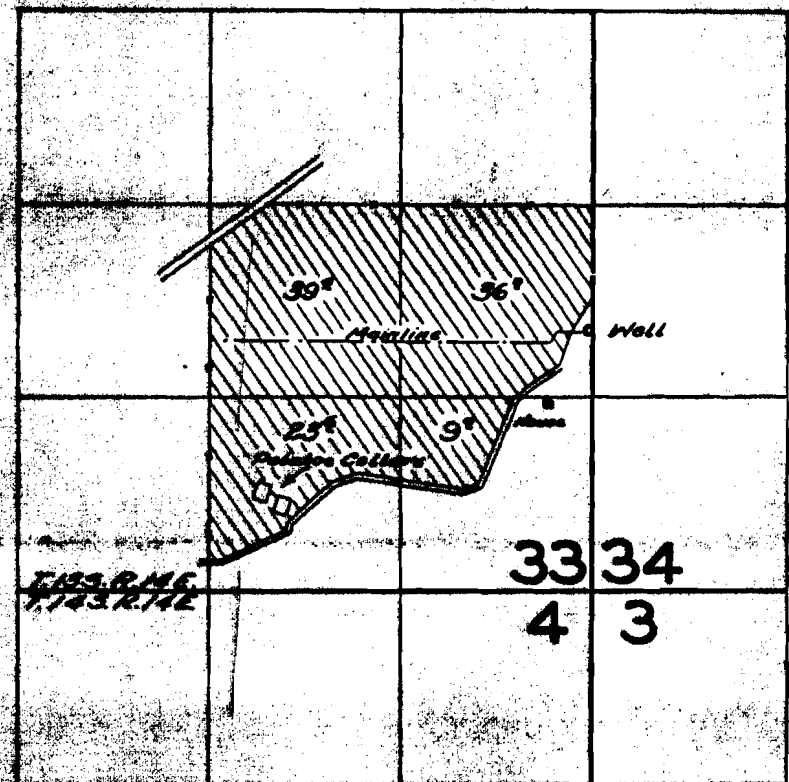

FINAL PROOF SURVEY UNDER

Application No. G-326... Permit No. G-442...
IN NAME OF

BUCKNER BROS.

Surveyed June 19 1939, by B.O. Baile