


T.13&14S., R.14E. W.M.

COPY

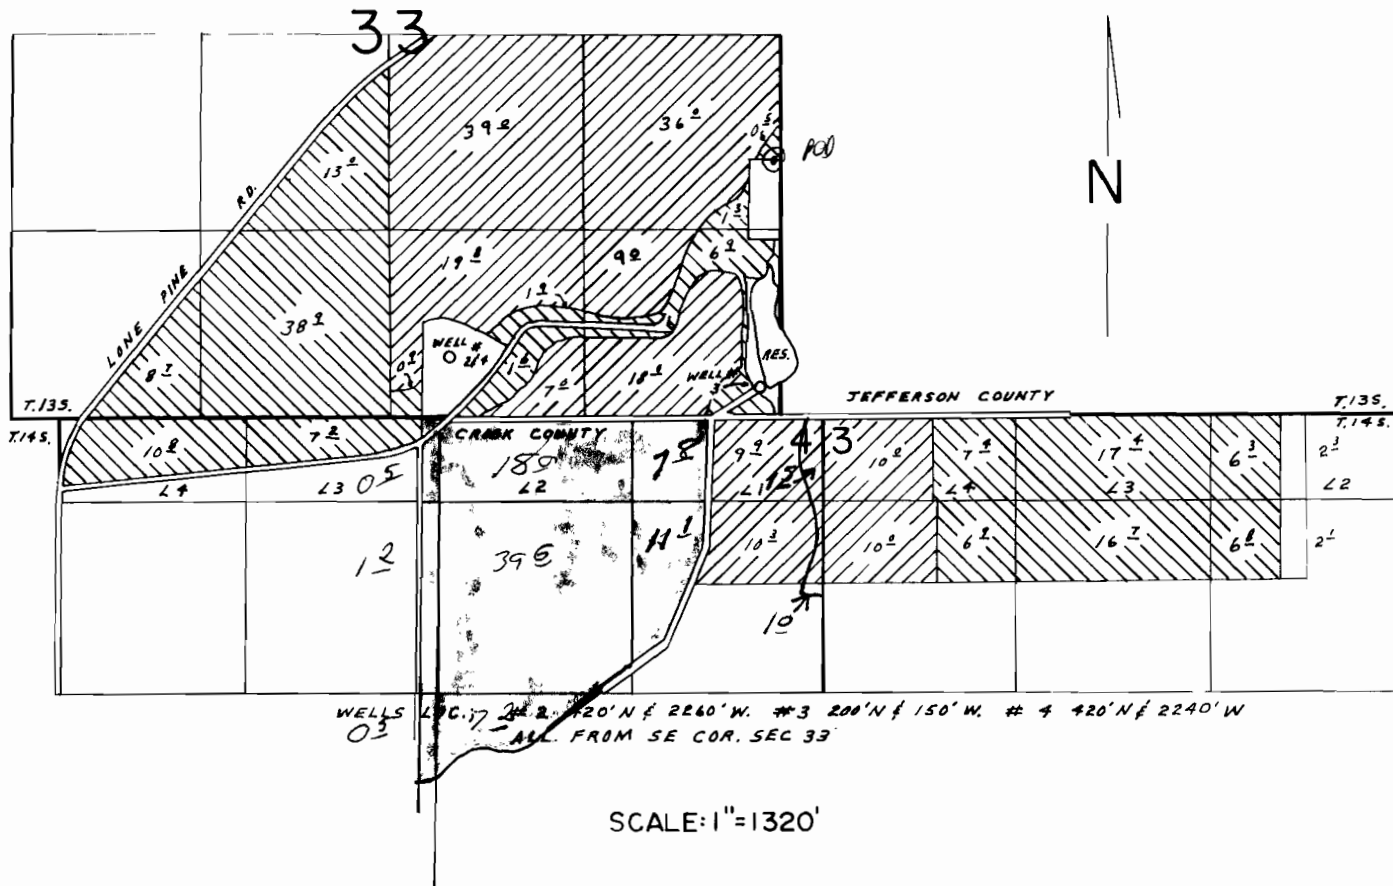

- Primary from Wells 2 & 3 Supplemental from Well 4
- Supplemental from Wells 2, 3, 4

FINAL PROOF SURVEY
UNDER

Application No. G-8474 G-7907
 G-8475 Permit No. G-7908.....
 IN NAME OF

.....
 HAROLD BUCKNER

Surveyed APR. 25 19.88, by B. BISHOP.....