



C-47-18

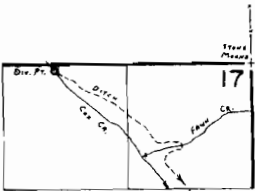

T.37S. R20E. W.M.

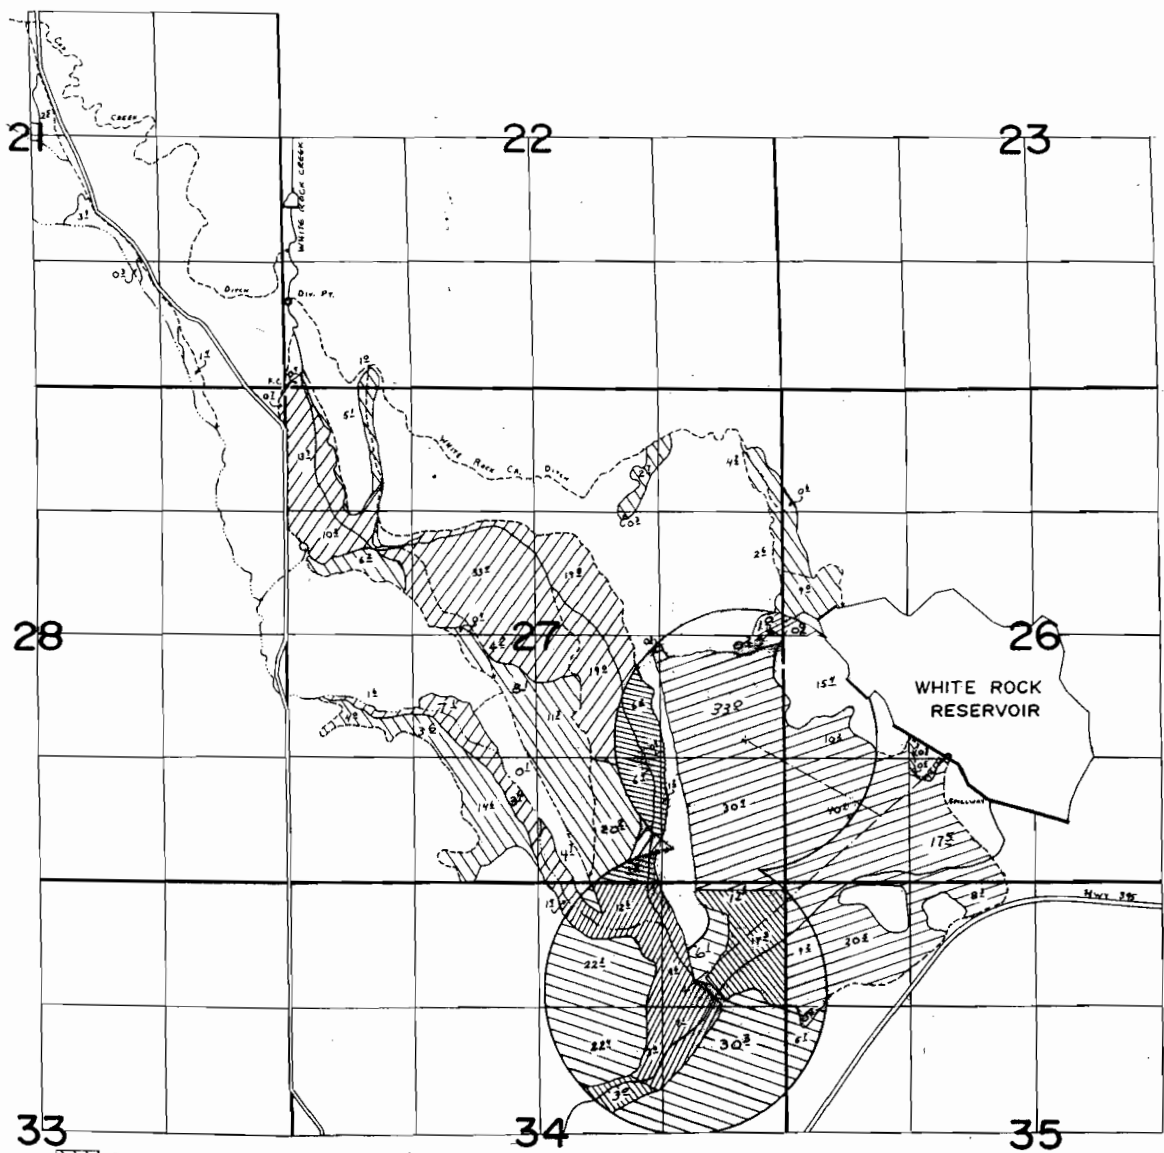

- PRIMARY IRRIGATION: WHITE ROCK CREEK (A-34204); SUPPLEMENTAL I: COX CR. (A-49722)
- P.I.: WHITE ROCK CR. (A-34204); S.I.: COX CR. & RESERVOIR (A-49722), RES. (A-53814)
- P.I.: WHITE ROCK CR./RES. (A-34204); S.I.: COX CR./RES. (A-49722), RES. (A-53814)
- P.I.: COX CR./RES. (A-53814)
- S.I.: WHITE ROCK CR./RES. (A-34204), COX CR./RES. (A-49722), RES. (A-53814)
- S.I.: COX CR. (A-49722)
- S.I.: COX CR./RES. (A-49722), RES. (A-53814)
- S.I.: COX CR./RES. (A-49722), RES. (A-53814)

**FINAL PROOF SURVEY**  
UNDER

R-34203	R-2982
34204	28099
R-49721	R-6026
49722	37122
R-53813	R-6507
Application No. 53814	Permit No. 40829

IN NAME OF

**TAYLOR RANCH, INC.**

Surveyed June 5, 1980, by Chris L. Hughes

Div. Pr. Loc: White Rock Cr. - 840' N & 50' E, fr. S.W. Cor. Sec. 22.  
Cox Cr. - 60' S. & 2080' W. fr. N.E. Cor. Sec. 17.  
**White Rock Reservoir - 1340' N & 1730' E**  
**fr SW Cor. Sec 26**