



CLAIM OF BENEFICIAL USE MAP FOR T-10174

T. 38 S., R. 7 W., W. M., JOSEPHINE COUNTY

Portions of Section 9

July 9, 2007

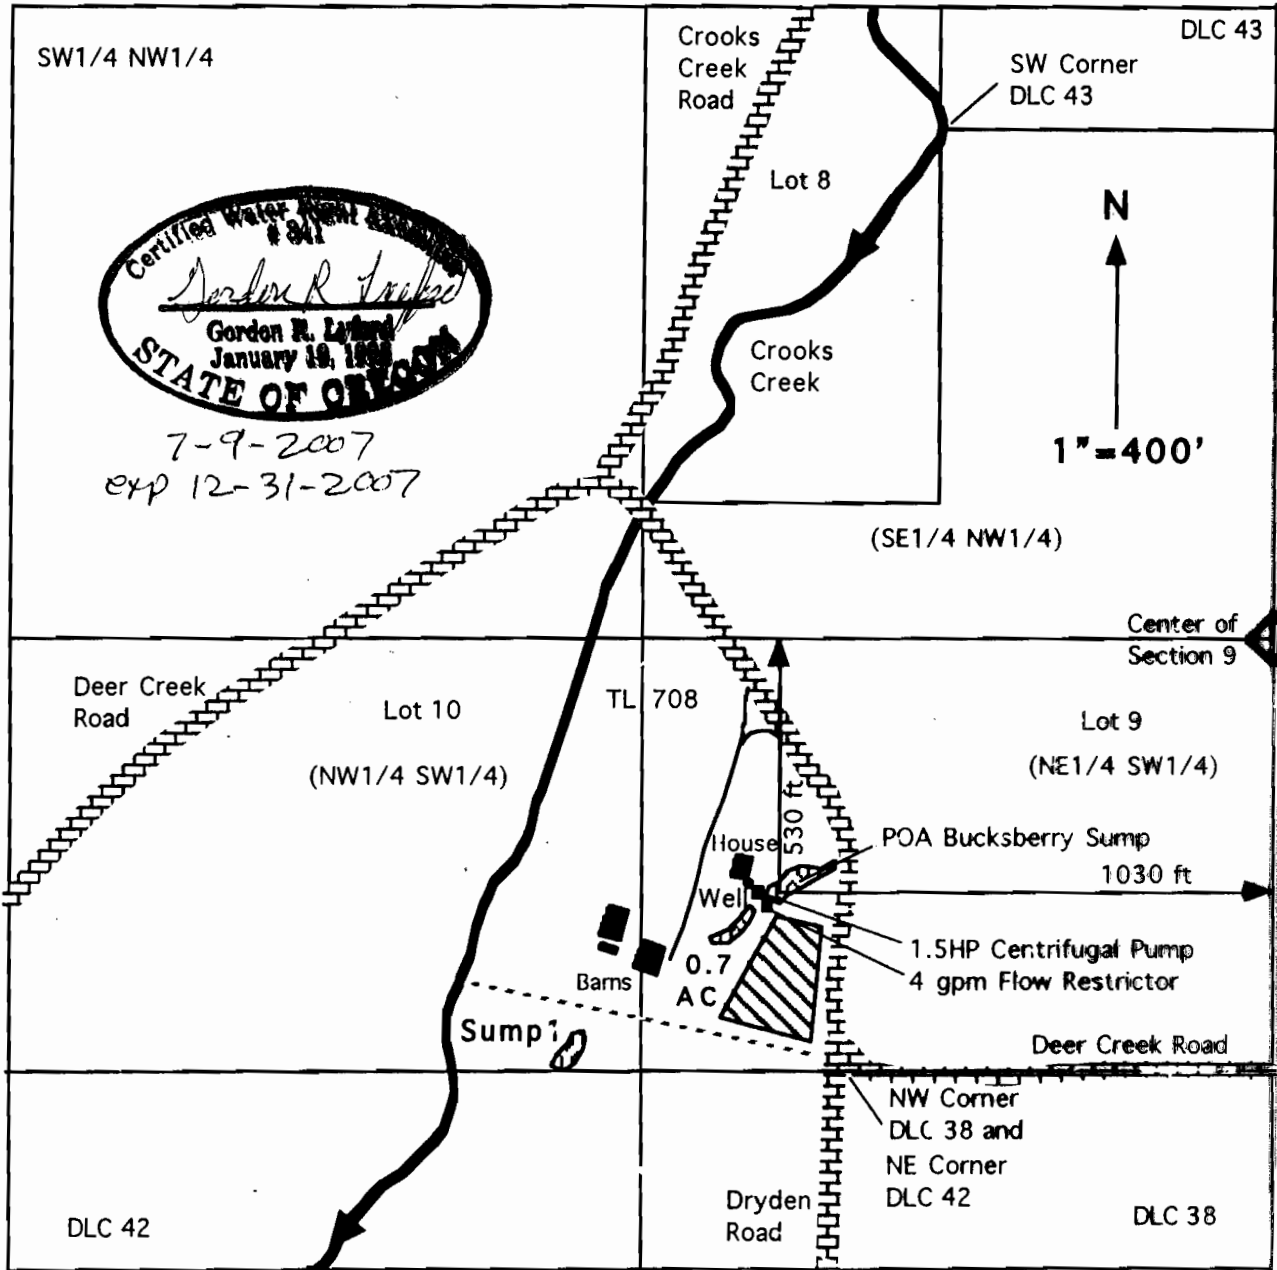

 Irrigation Water Rights with a priority of August 18, 1976 under T-10174 from Application G-7484, Permit G-9921, and canceled Certificate #66460.

This map was drawn by Gordon R. Lyford for Joel Buck and Margaret Brandeis to support their Claim of Beneficial Use under T-10174. Joel Buck and Margaret Brandeis own tax lot 708. **RECEIVED**

This map was prepared for the purpose of identifying the location of water rights only and is not intended to provide legal dimensions or the location of property ownership lines.

Handwritten notes and stamps:
 JUL 10 2007
 RECEIVED
 JUL 10 2007