

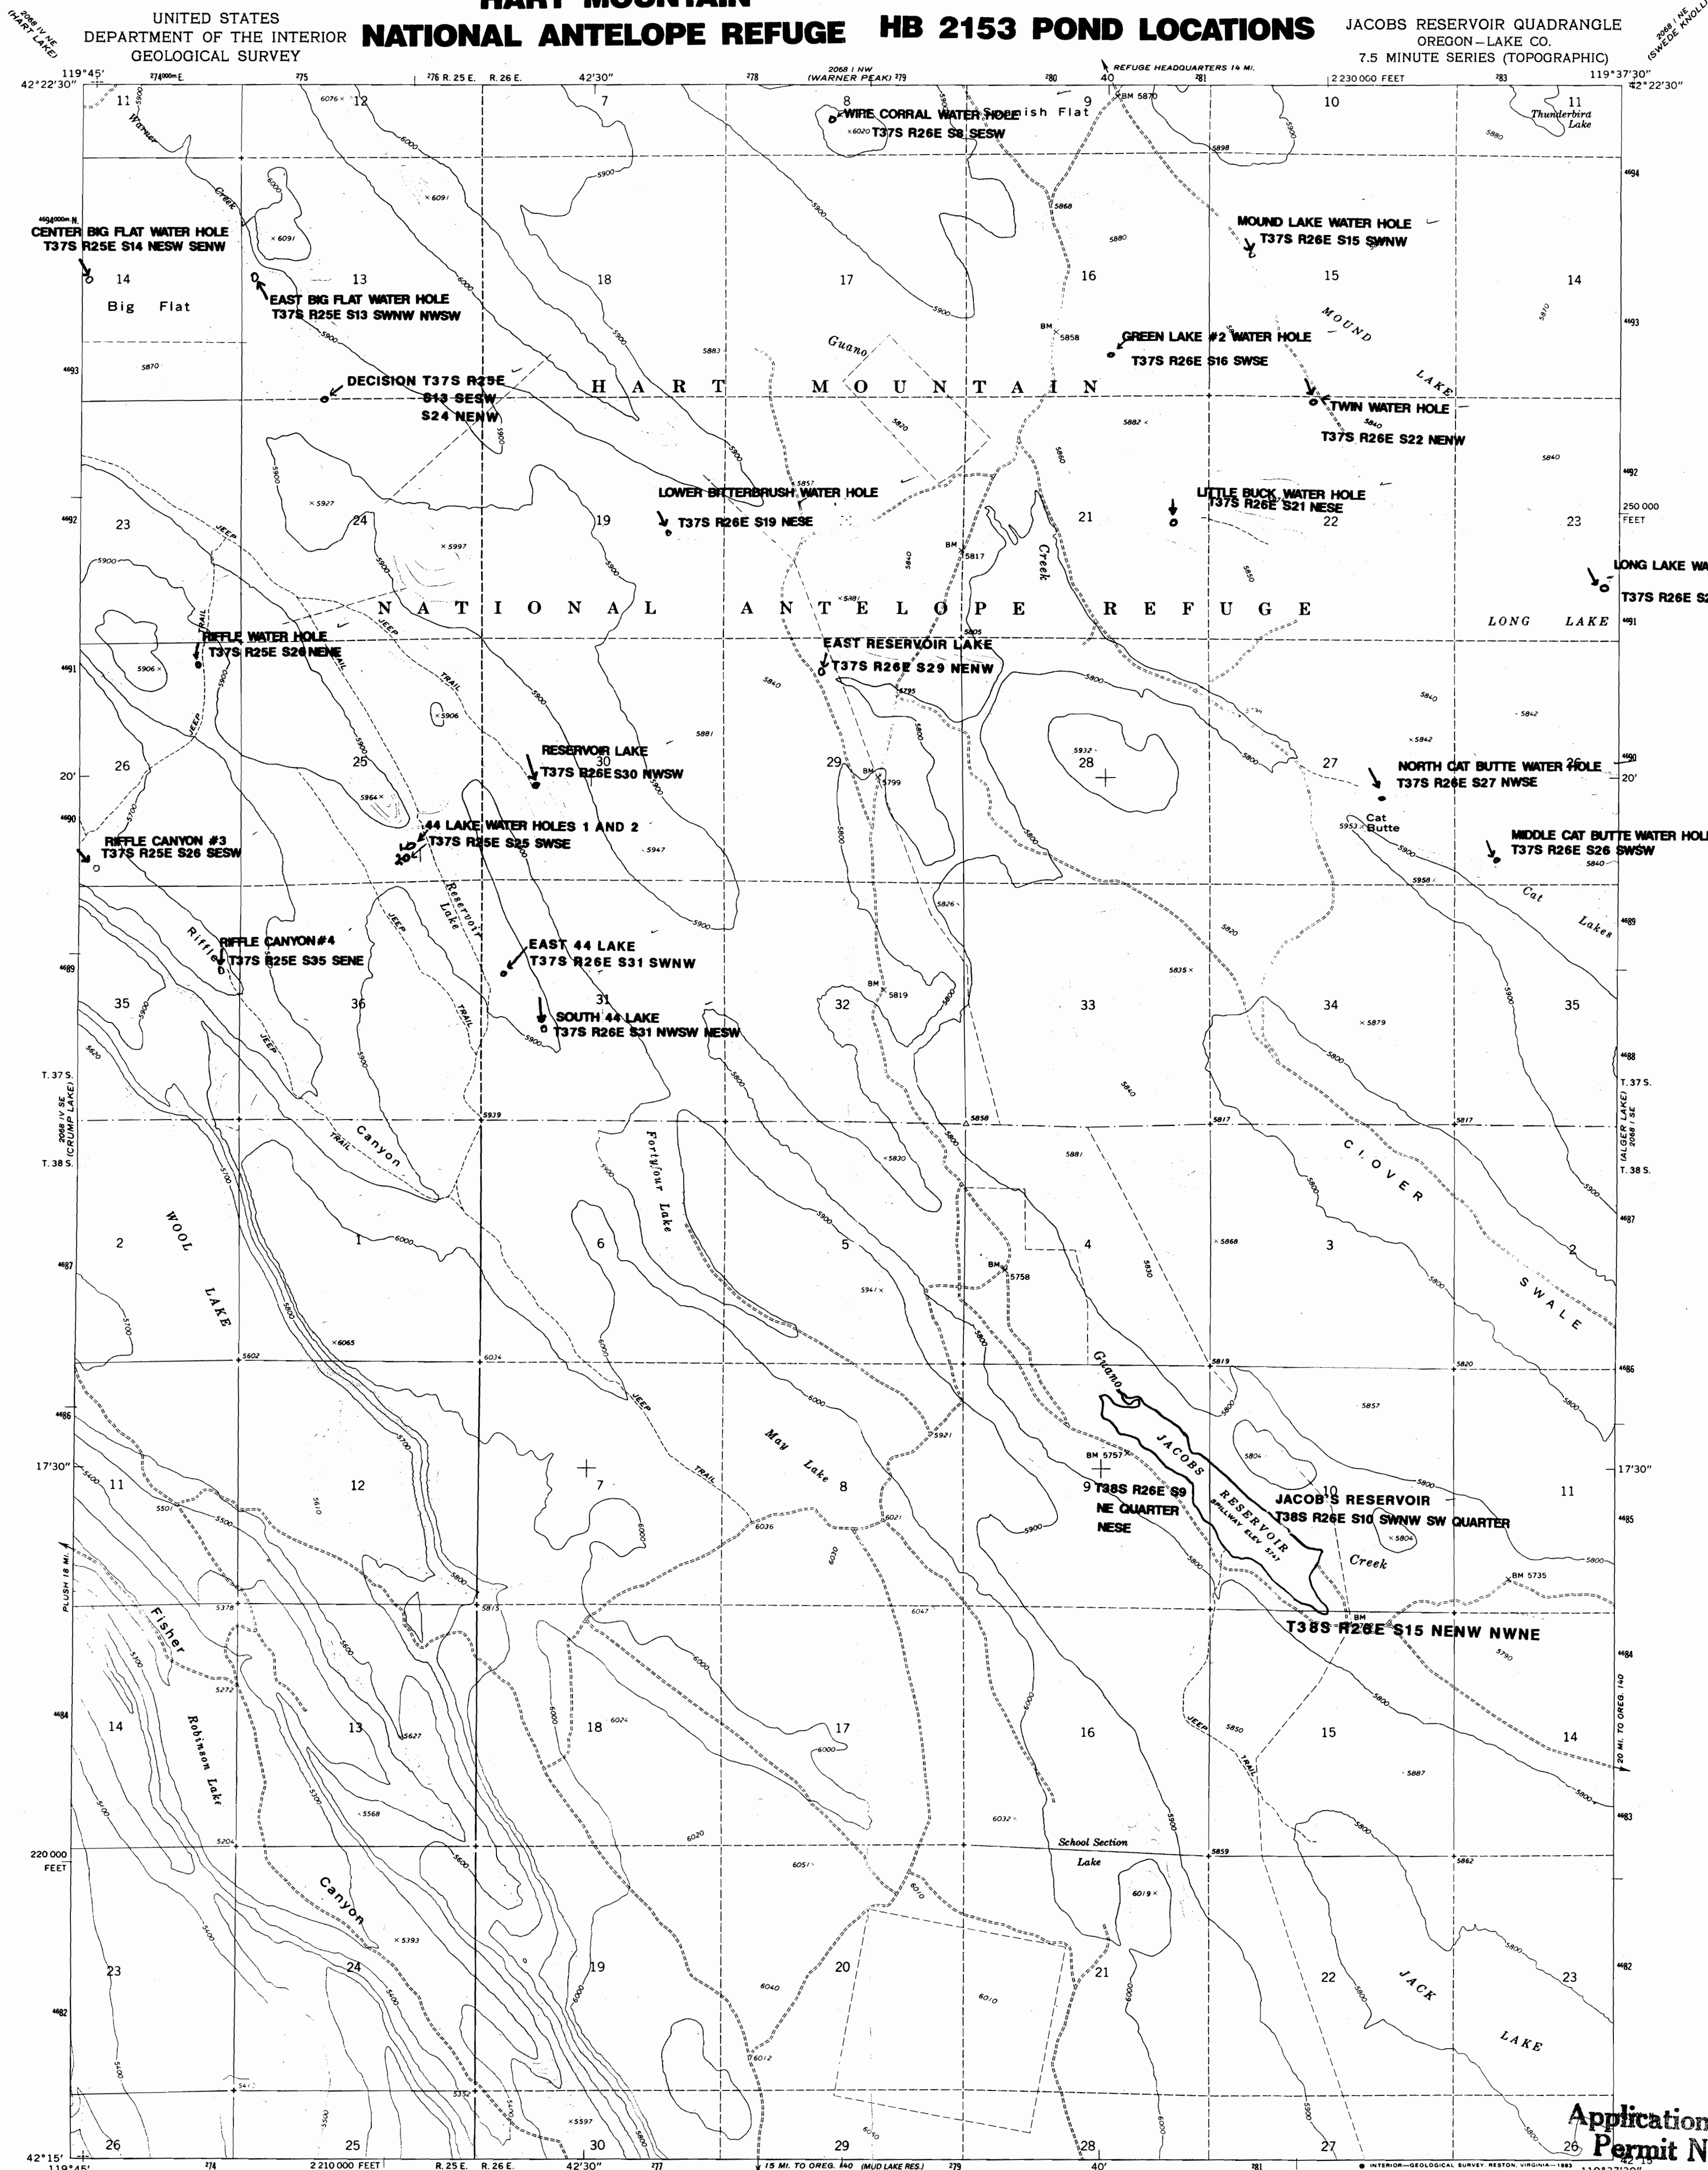


HART MOUNTAIN
NATIONAL ANTELOPE REFUGE HB 2153 POND LOCATIONS

JACOBS RESERVOIR QUADRANGLE
OREGON—LAKE CO.
7.5 MINUTE SERIES (TOPOGRAPHIC)

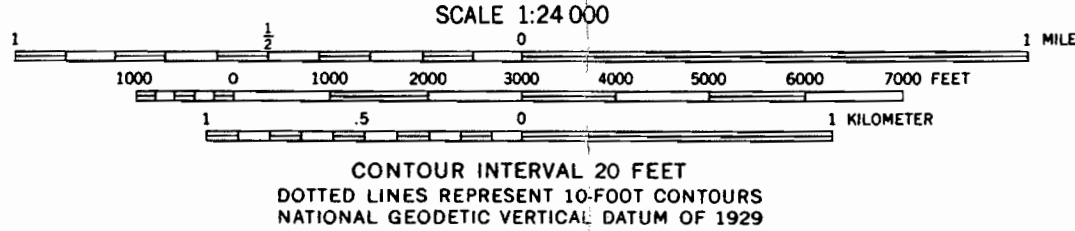

Mapped, edited, and published by the Geological Survey
Control by USGS and USC&GS
Topography by photogrammetric methods from aerial
photographs taken 1964. Field checked 1967
Polyconic projection. 1927 North American datum
10,000-foot grid based on Oregon coordinate system,
south zone
1000-meter Universal Transverse Mercator grid ticks,
zone 11, shown in blue
To place on the predicted North American Datum 1983
move the projection lines 17 meters north and
86 meters east as shown by dashed corner ticks
There may be private inholdings within the boundaries of
the National or State reservations shown on this map

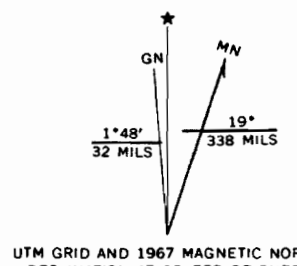

THIS MAP COMPLIES WITH NATIONAL MAP ACCURACY STANDARDS
FOR SALE BY U. S. GEOLOGICAL SURVEY, DENVER, COLORADO 80225, OR RESTON, VIRGINIA 22092
A FOLDER DESCRIBING TOPOGRAPHIC MAPS AND SYMBOLS IS AVAILABLE ON REQUEST



JACOBS RESERVOIR, OREG.
N4215—W11937.5/7.5
1967
PHOTOINSPECTED 1979

ROAD CLASSIFICATION
Unimproved dirt -----

Application No. P-15325
Permit No.

NOV 21 1994

WATER RESOURCES DIV.
SALEM, OREGON