


T.36S.,R.14E.,W.M.

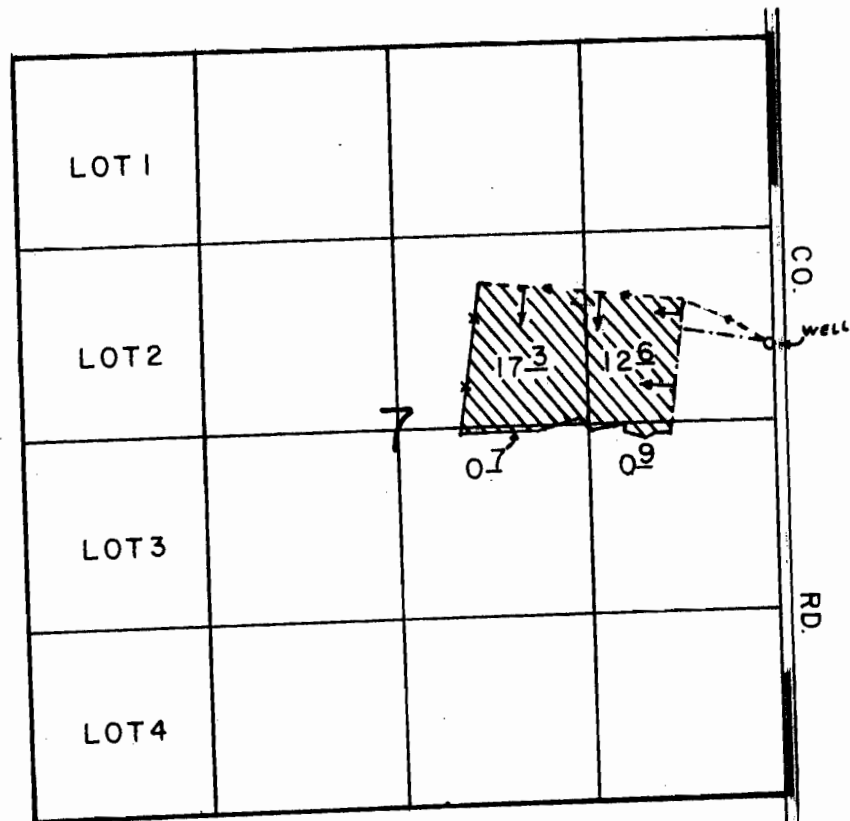

WELL LOC.: 2100' S. & 50' W. FROM NE COR. OF SEC. 7.  
2075 100

SCALE: 1" = 1320'

### FINAL PROOF SURVEY UNDER

Application No. G-10174 Permit No. G-9207...  
IN NAME OF

SIMONSEN FAMILY TRUST

Surveyed AUG. 13. 19. 91., by B.W. BISHOP

10/31/06 LHM  
P.T.S 11-8-91 R.M.S