

T. 4S. R. 10W., W.M.

FOUND 3" BRASS CAP  
1/4 COR.

TILLAMOOK COUNTY, OREGON

SEC 1


1

SEC 12

12

NW 1/4 NE 1/4

NE 1/4 NE 1/4

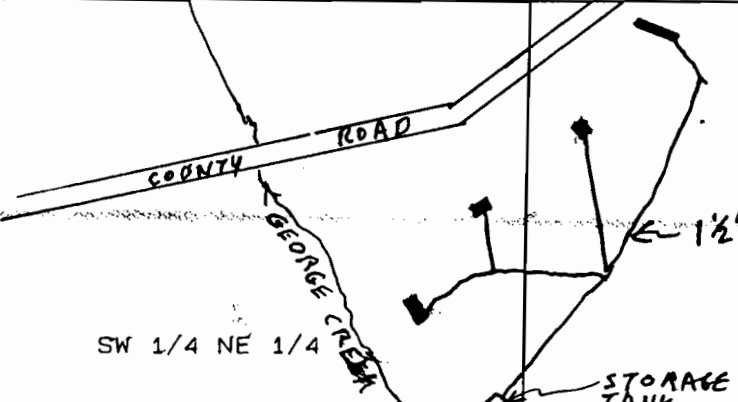

SW 1/4 NE 1/4

SE 1/4 NE 1/4

1 1/2" PLASTIC

STORAGE TANK  
 POINT OF DIVERSION  
 S 2384.22 FEET  
 E 1082.32 FEET FROM NORTH  
 1/4 CORNER OF SECTION 12  
 T4S R10W, W.M.

SCALE  
1" = 400'

12

FINAL PROOF SURVEY

APPLICATION NO. 71743

PERMIT NO. 51323 IN THE NAME OF

K. KIRKPATRICK, MARVIN NOBLE, ROBERT DAY & C.R. EMERSON

FEBRUARY 3, 1992

