


T12S R23E W.M.

All In Tax Lot 12-23 609

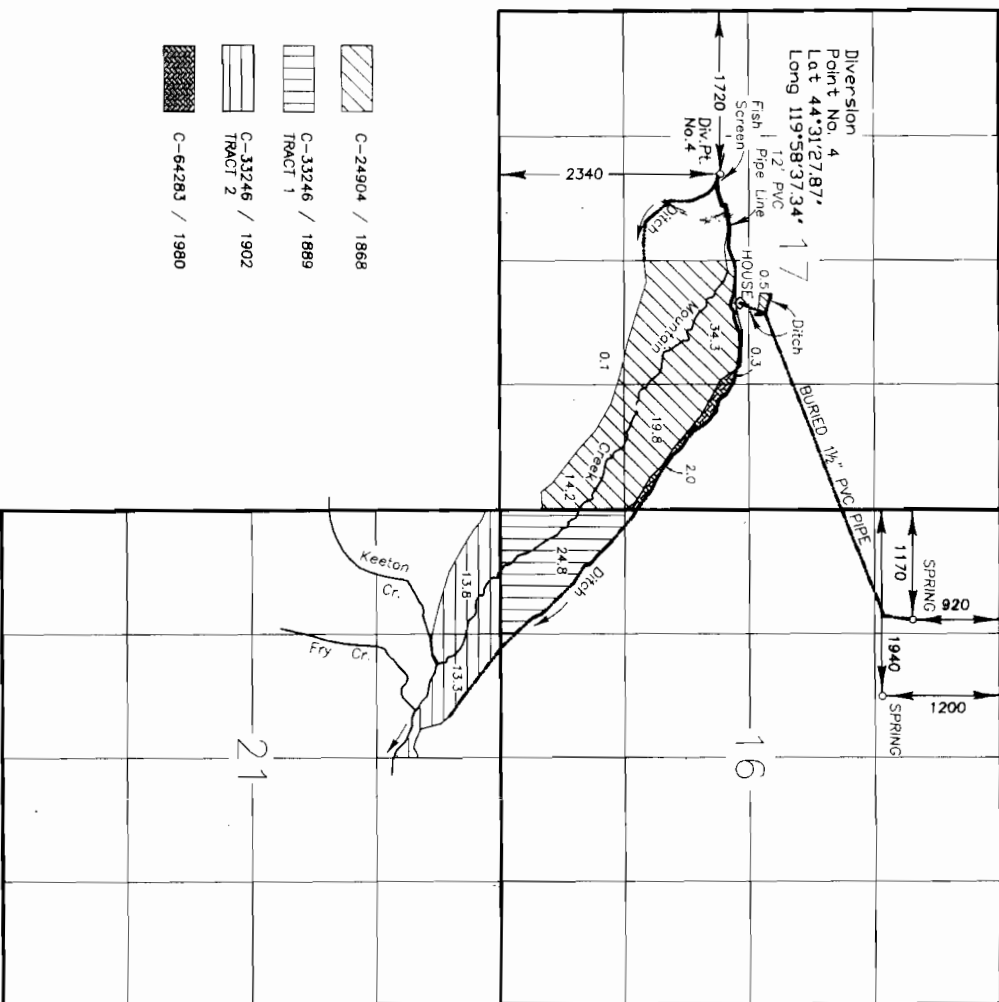

NOTE: The preparation of this map was for the purpose of identifying the location of the proposed water right and has no intent to provide dimensions or location of property ownership lines. Location information shown hereon was furnished by the applicant.



Scale 1"=1320'

RECEIVED
JUL 03 2007
WATER RESOURCES DEPT
SALEM, OREGON

FINAL PROOF SURVEY
UNDER TRANSFER T-9562

IN THE NAME OF
HERBERT M. JONES
SURVEYED JUNE 27, 2003
BY CARL STOUT

