


# T12S R23E W.M.

All In Tax Lot 12-23 609

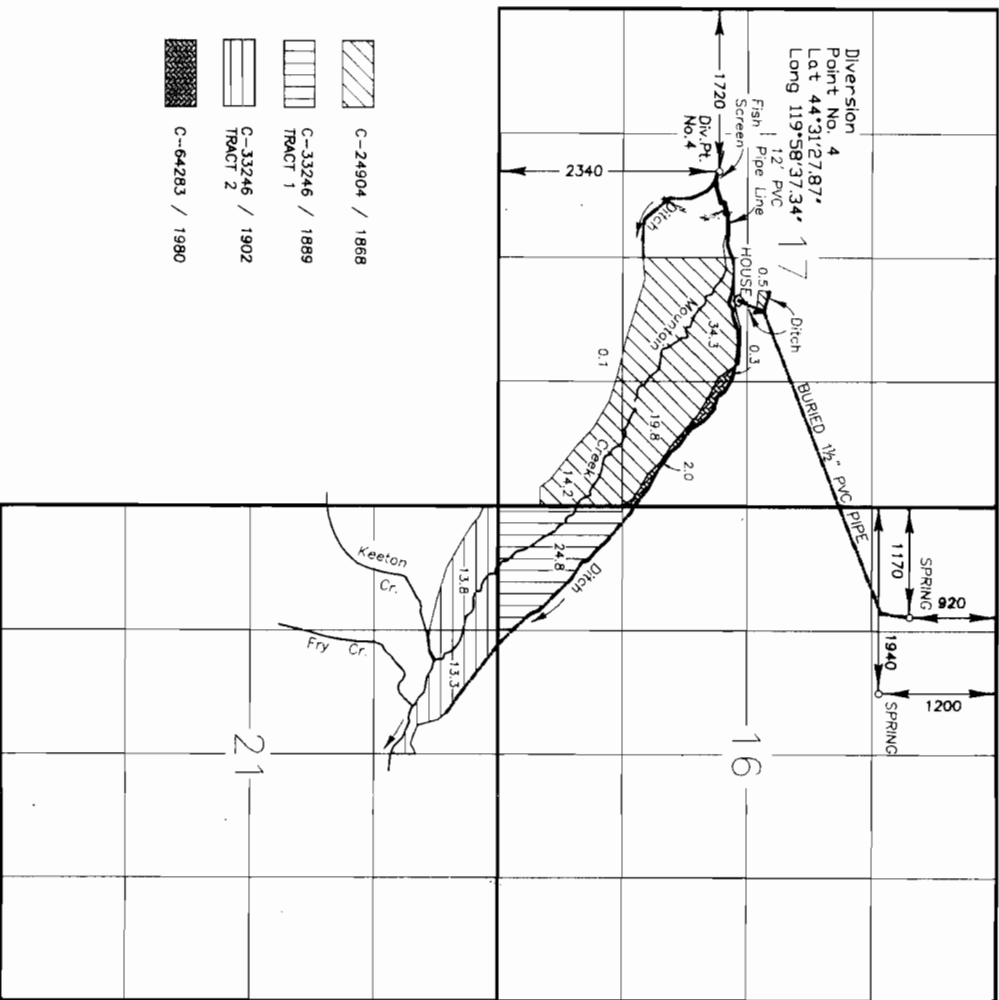

NOTE: The preparation of this map was for the purpose of identifying the location of the proposed water right and has no intent to provide dimensions or location of property ownership lines. Location information shown hereon was furnished by the applicant.



Scale 1"=1320'

**RECEIVED**  
JUL 03 2007  
WATER RESOURCES DEPT  
SALEM, OREGON

FINAL PROOF SURVEY  
UNDER TRANSFER T-9562

IN THE NAME OF  
HERBERT M. JONES  
SURVEYED JUNE 27, 2003  
BY CARL STOUT

