
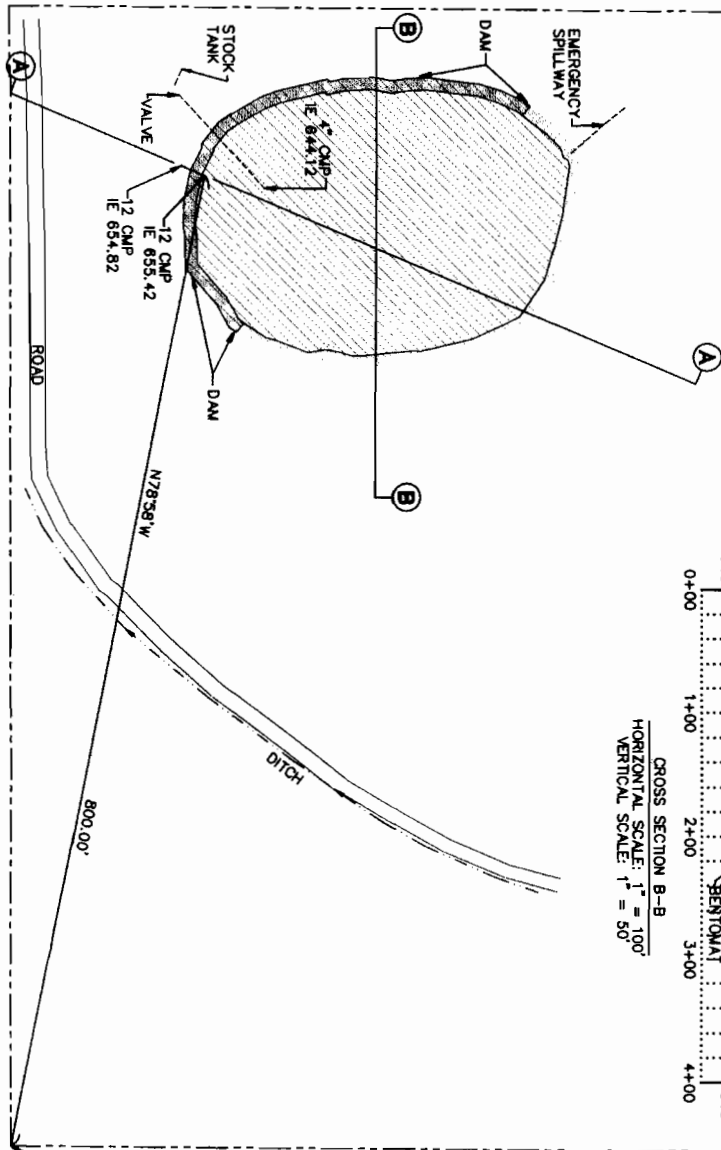
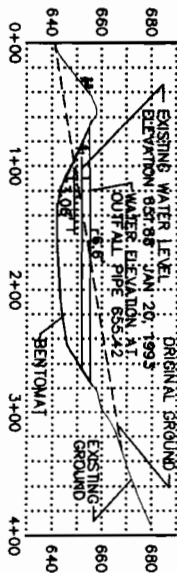


SEC 14, T. 7 S., R. 1 W., W.M. MARION COUNTY


PERMIT NO. R 1158 APR. R 70037

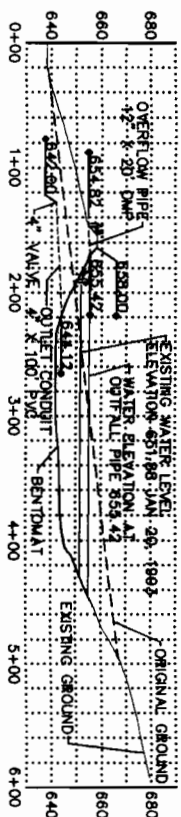

CROSS SECTION B-B
HORIZONTAL SCALE: 1" = 100'
VERTICAL SCALE: 1" = 50'

DAM LOCATED IN SE 1/4, NW 1/4 OF SECTION 14, T. 7 S., R. 1 W., W.M.

- LEGEND**
- DITCH
 - PROPERTY LINE
 - RESERVOIR
 - RESERVOIR BERM
 - RESERVOIR DAM

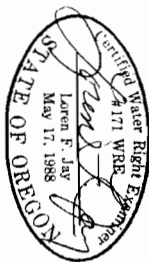

THIS MAP WAS PREPARED FOR THE PURPOSE OF IDENTIFYING THE LOCATION OF THE WATER RIGHT ONLY AND HAS NO INTENT TO PROVIDE DIMENSIONS OR LOCATIONS OF PROPERTY OWNERSHIP LINES.

STOCK POND BEARING RECOMMENDATIONS	
NORMAN BERKE	
WATER RIGHTS MAP	
Scale: 1" = 200'	Date: 11/11/98
Drawn: L.F.J.	Checked: J.F.J.
1	1

