



**T.27S., R.1W., W.M.
SW1/4, SECTION 28**

THE PURPOSE OF THIS MAP IS TO IDENTIFY THE LOCATION OF THE WATER RIGHT. IT IS NOT INTENDED TO PROVIDE INFORMATION RELATIVE TO THE LOCATION OF PROPERTY OWNERSHIP BOUNDARY LINES.

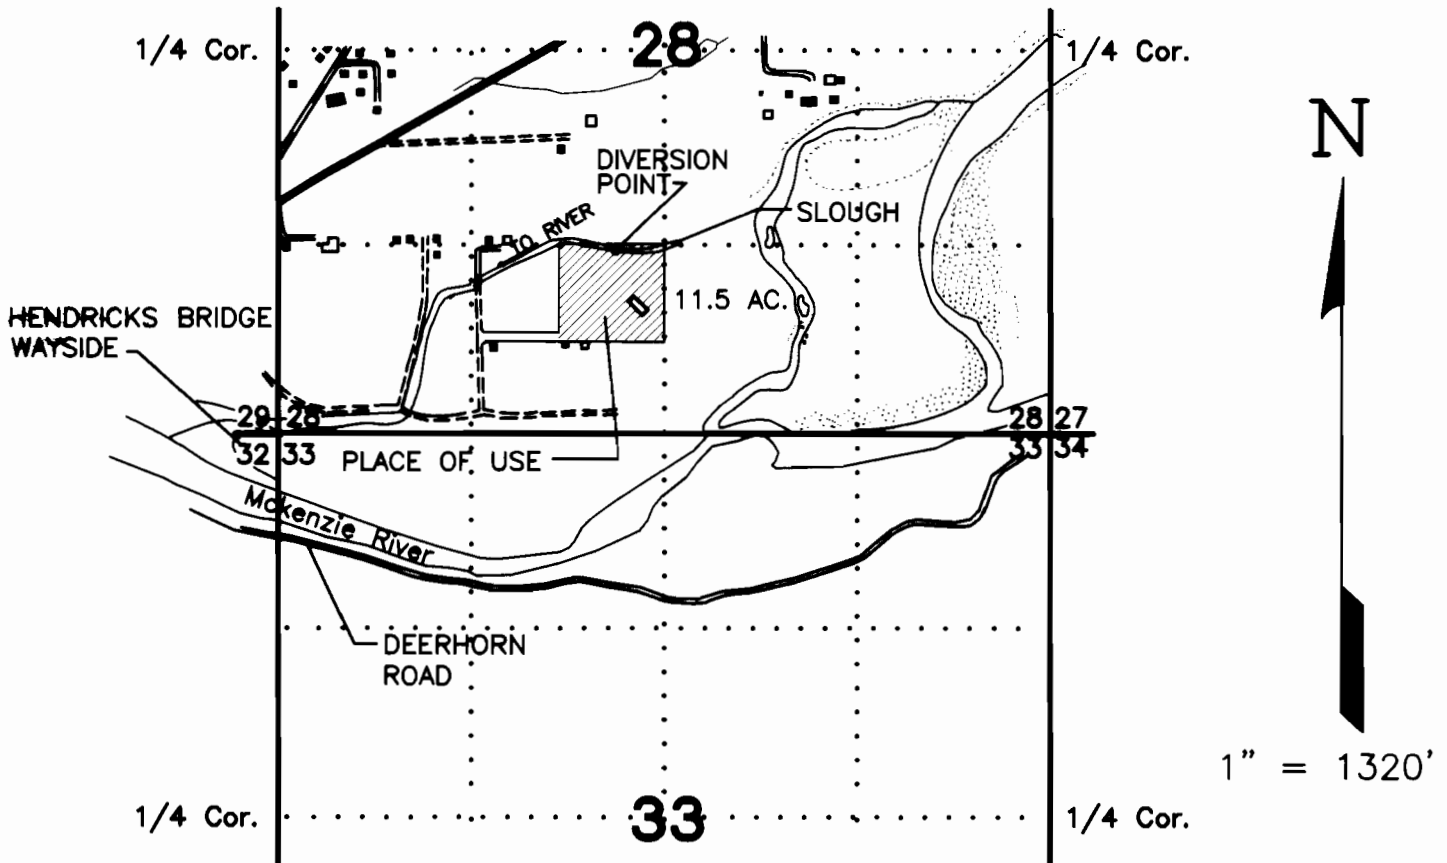

THE DIVERSION POINT IS LOCATED 1240' NORTH AND 345' WEST OF THE S.E. CORNER OF THE SW 1/4 OF SEC. 28.

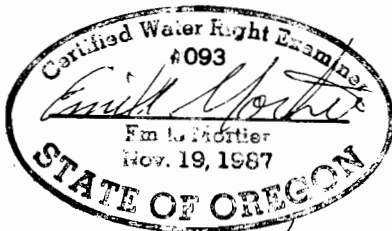

FINAL PROOF SURVEY

UNDER

Application No. **72056** Permit No. **52015**

IN THE NAME OF

BOB GORDON

Surveyed ...**JUNE.2.....** 20**00..** by **JON.HARTWELL..**

revised 7-28-04 SD