RECEIVED
FEB 9 1995
WATER RESOURCES DEPT.
SALEM, OREGON

37-24-31

This print is made soley for the purpose of assisting in locating said premises and the company assumes no liability for variations, if any, in dimensions and locations ascertained by actual survey.

JACKSON COUNTY TITLE
DIVISION OF CONTINENTAL LAND TITLE CO.
502 W. MAIN Ph. 779-2811 MEDFORD, OREGON

Sec. 31 T. 37 S

RECEIVED
JAN - 6 1995
WATER RESOURCES DEPT.
SALEM, OREGON

1" = 400'

37 2W 30

49-47

Application No. R-77613

Permit No.

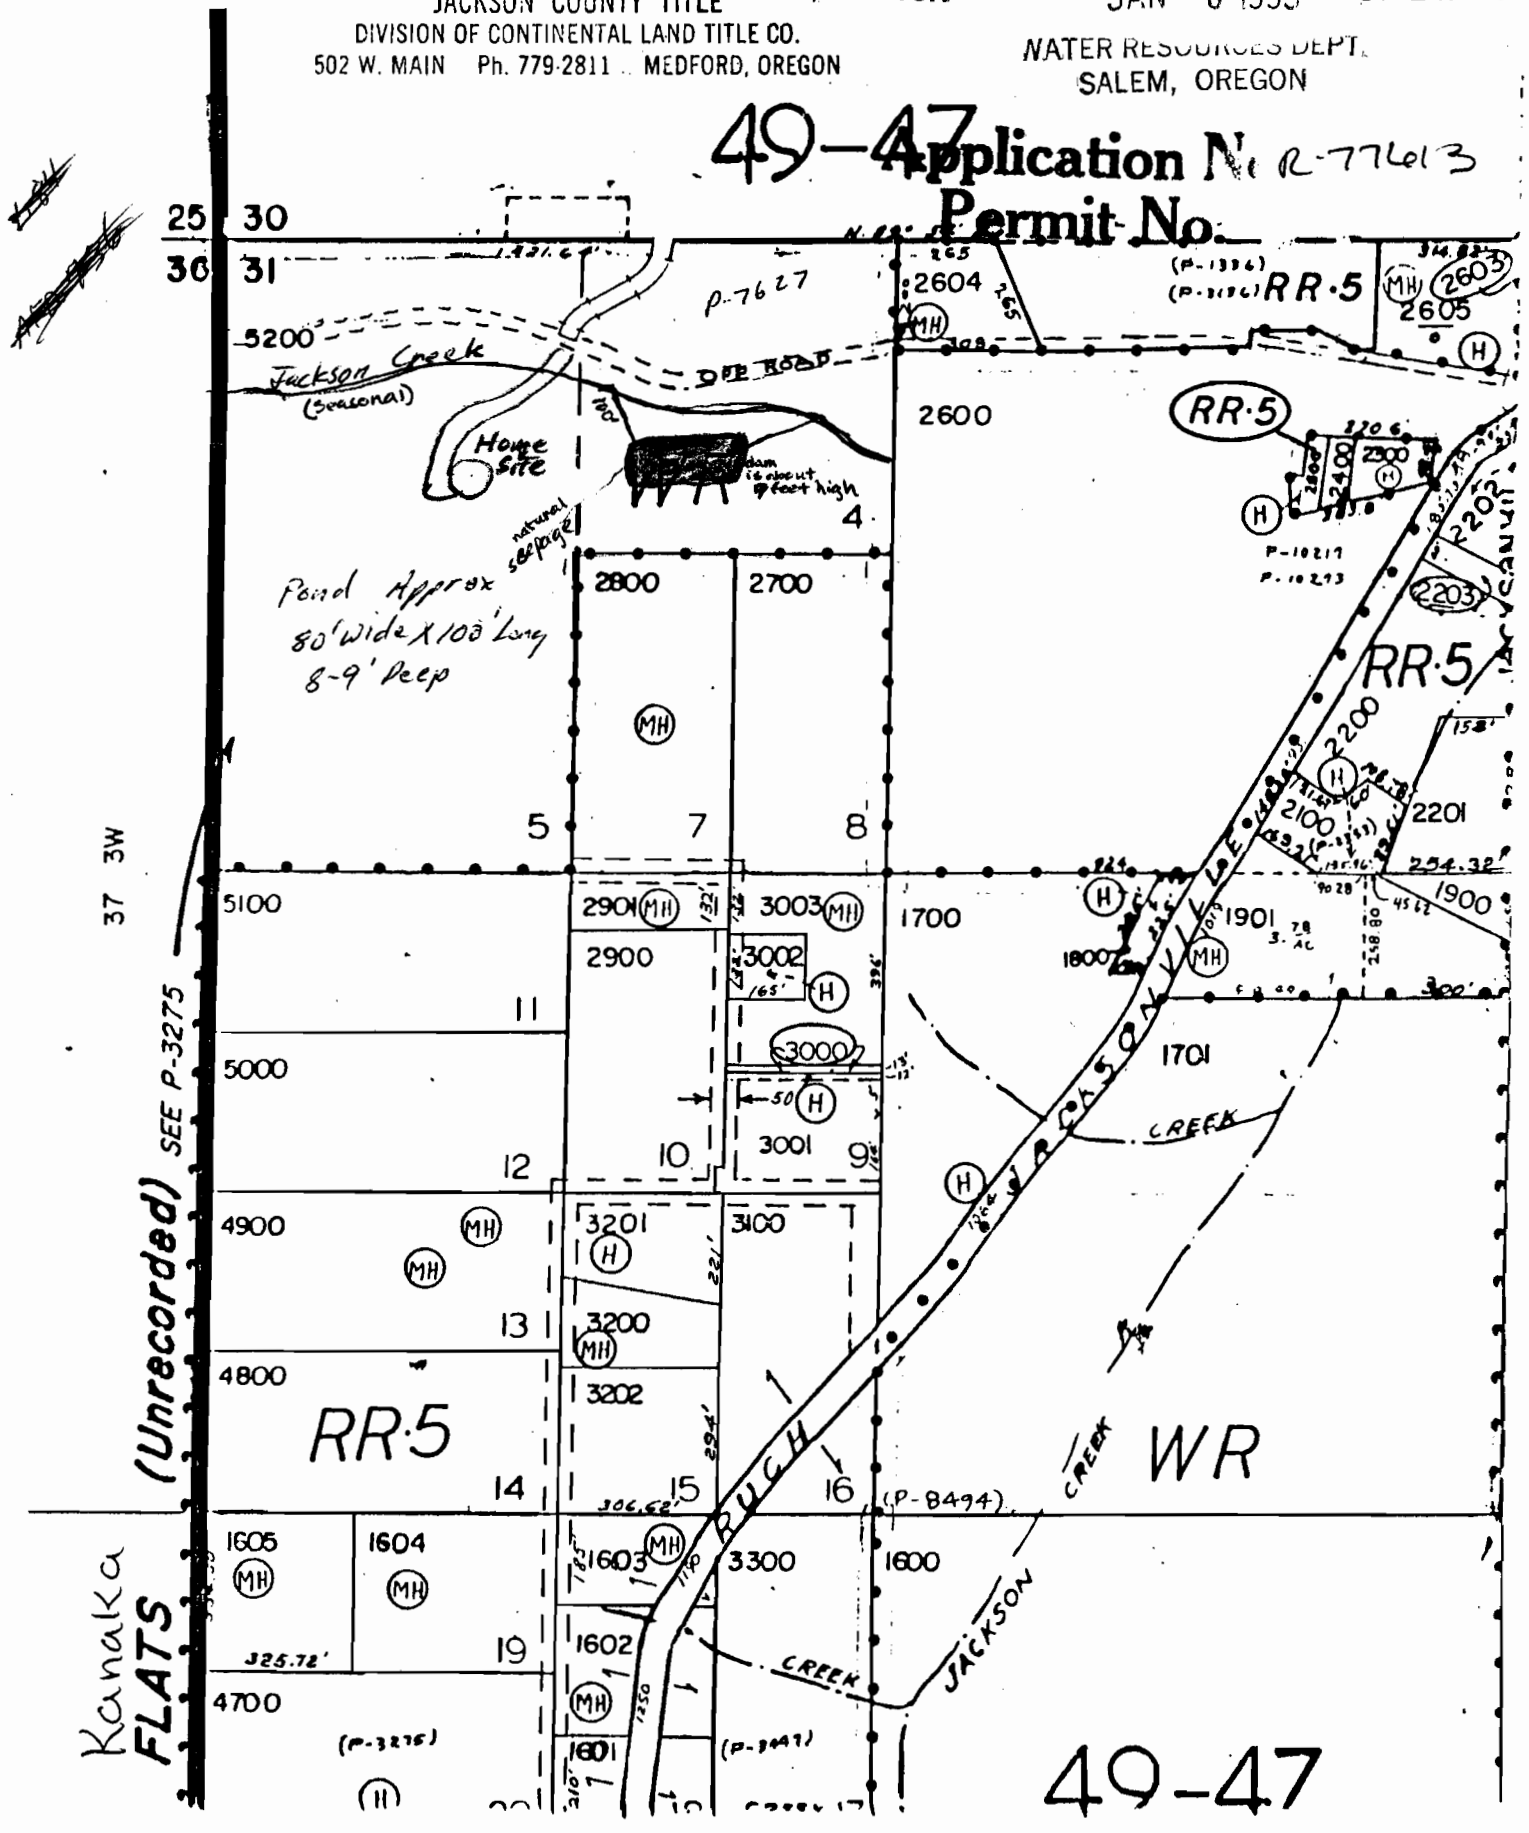

49-47

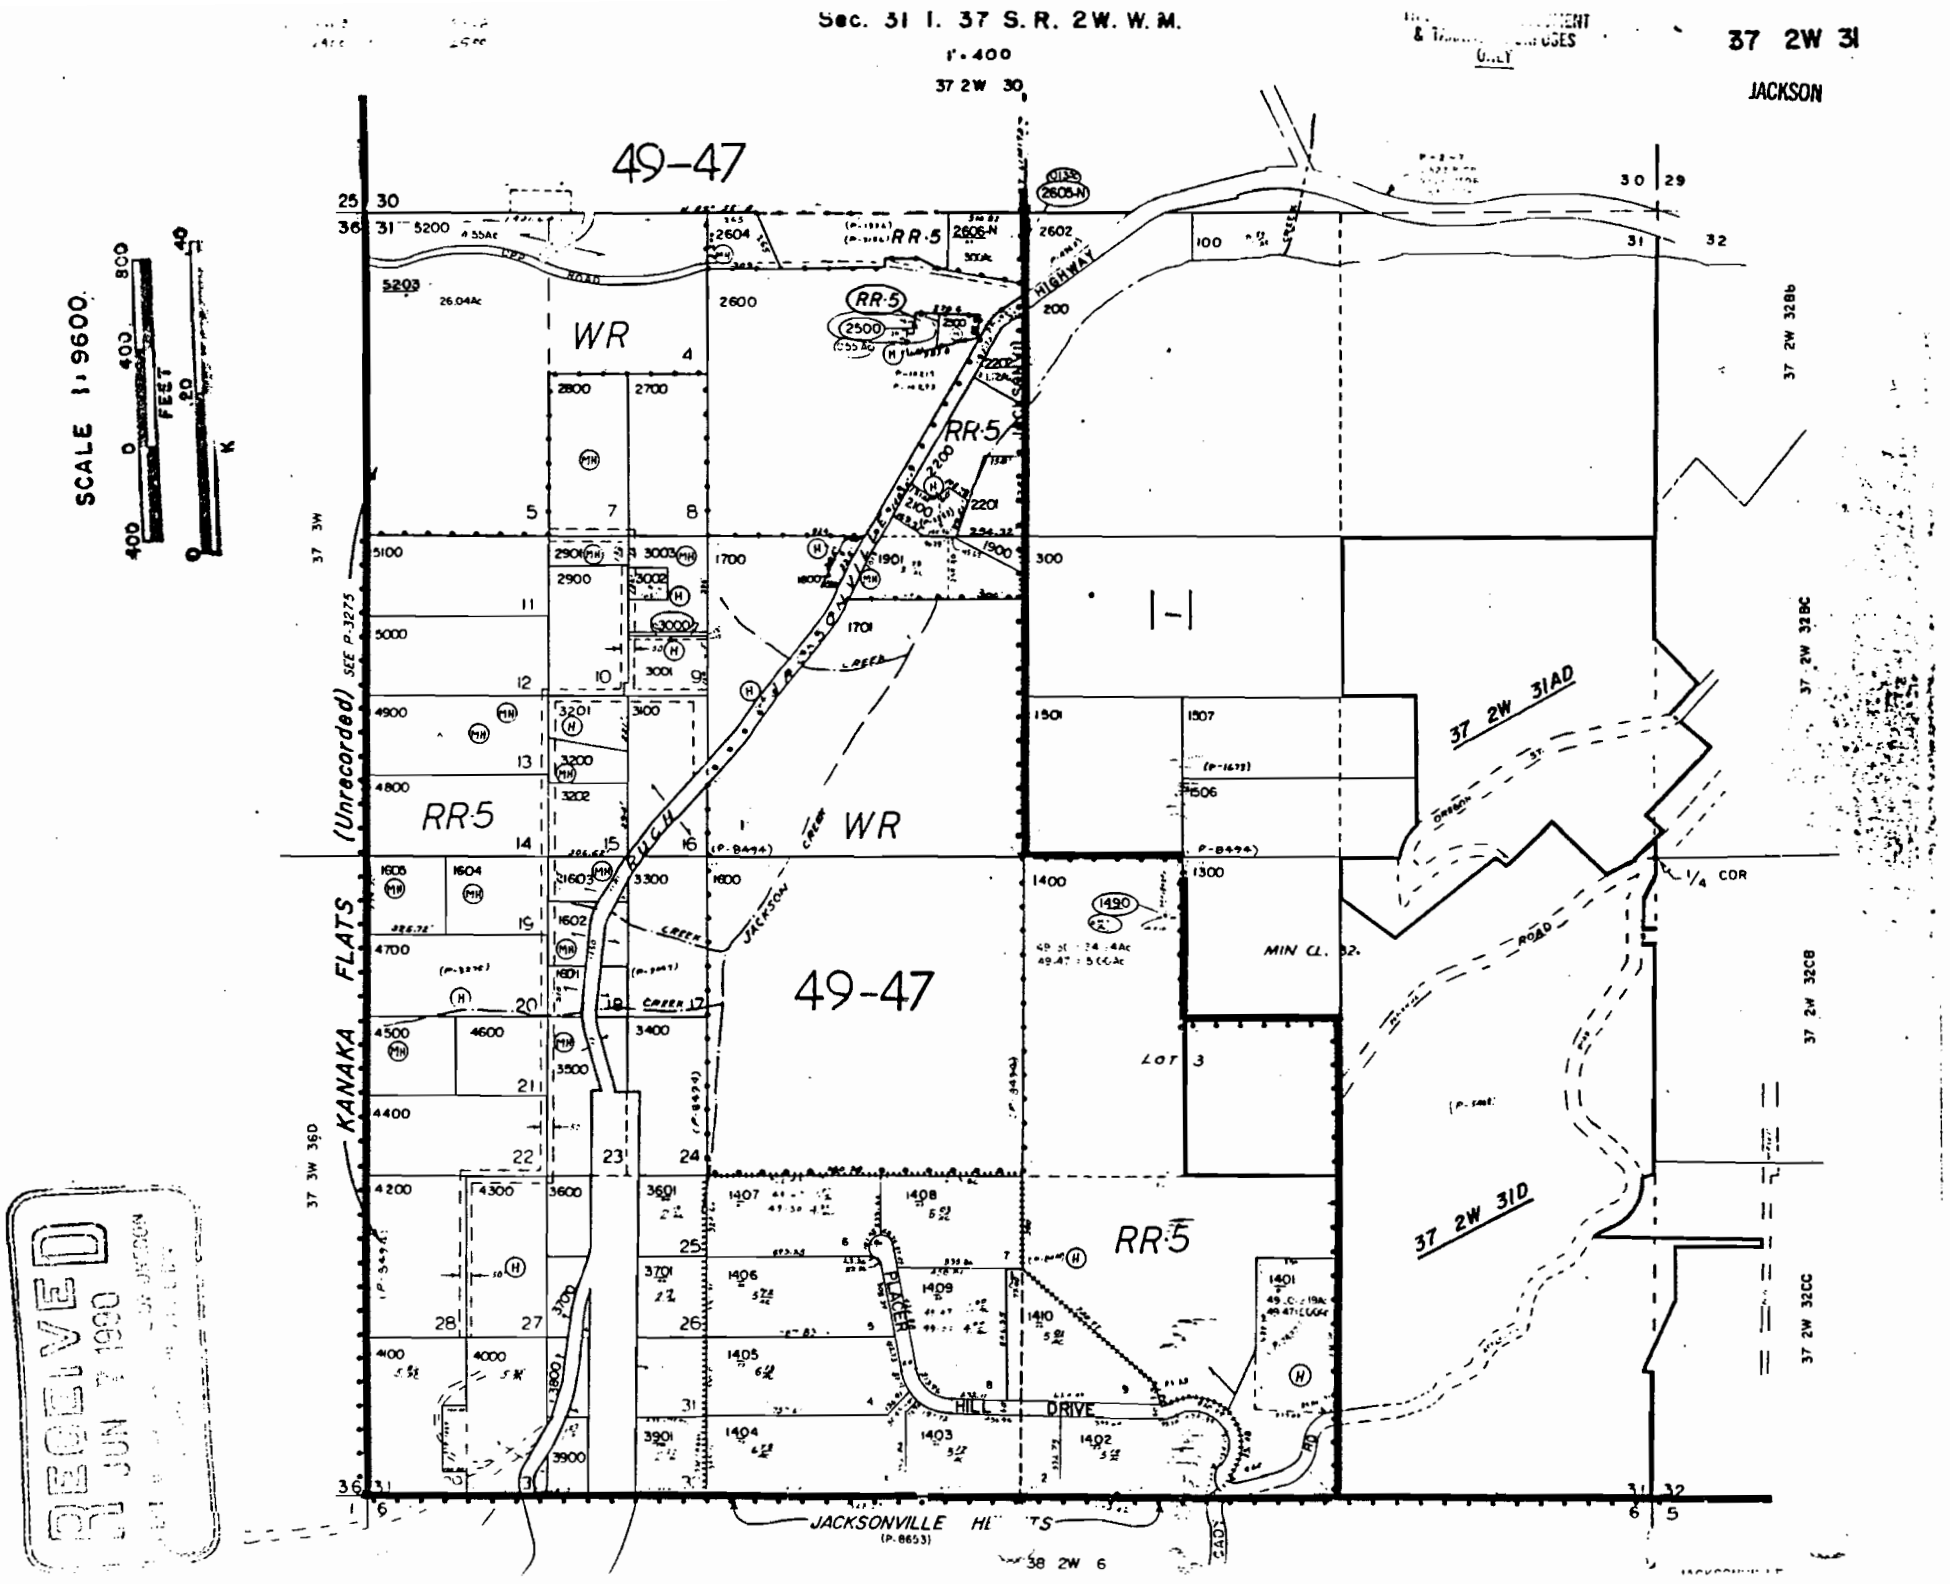
Sec. 31 T. 37 S. R. 2W. W.M.
1"=400'
37 2W 30
37 2W 31
JACKSON
SCALE 1:9600
FEET
49-47
RR-5
WR
(Unrecorded) SEE P-3275
KANAKA FLATS
BUCH CREEK
JACKSONVILLE HIGHWAY
JACKSON CREEK
PLACER HILL DRIVE
MIN CL.
LOT 3
1/4 COR
37 2W 31AD
37 2W 31D
37 2W 32BB
37 2W 32BC
37 2W 32CB
37 2W 32CC
37 3W 36D
JACKSONVILLE HEIGHTS
(P-8653)
38 2W 6
RECEIVED
JUN 7 1990