

APPROVED SEPT. 4, 1908 (SGD) C. E. ROBERTS, COUNTY SURVEYOR.  
APPROVED SEPT. 4, 1908 (SGD) GEO. W. STALEY ASSESSOR  
BY F. L. CALKINS, DEPUTY  
APPROVED SEPT. TERM 1908. G. W. WONACOTT COUNTY JUDGE. (SGD)  
FILED SEPT. 4, 1908 (SGD) E. H. LENOX, COUNTY CLERK

# ROSEBURG HOME - ORCHARD TRACTS DOUGLAS COUNTY OREGON

BEING DONATION LAND CLAIM NO 37, T. 26 S., R. 7 W. AND DONATION LAND CLAIMS NOS 58 AND 59 AND THE NORTH HALF OF THE NORTH HALF OF CLAIM NO 40 ALSO THE N E 1/4 OF THE SW 1/4 AND LOTS NOS 6, 7, 8, 9, 10, 11, 12 AND 13 OF SEC. 20, T. 26 S., R. 6 W., W.M.

ROBERTS AND GERMOND  
CIVIL ENGINEERS, 1908

J. H. BOOTH ET UX TO THE PUBLIC.  
KNOW ALL MEN BY THESE PRESENTS, THAT WHEREAS, ON THE 4TH DAY OF SEPTEMBER 1908, THERE WAS FILED IN THE OFFICE OF THE COUNTY CLERK OF DOUGLAS COUNTY, STATE OF OREGON, BY J. H. BOOTH A PLAT DESIGNATED "ROSEBURG HOME ORCHARD TRACTS" BEING DONATION LAND CLAIM NO 37 IN TOWNSHIP TWENTY SIX (26) SOUTH OF RANGE SEVEN (7) WEST AND DONATION LAND CLAIMS 58 AND 59 AND THE NORTH HALF (1/2) OF THE NORTH HALF (1/2) OF CLAIM NO 40, ALSO THE NORTH EAST QUARTER (1/4) OF THE SOUTH WEST QUARTER (1/4) AND LOTS NOS SIX (6) SEVEN (7) EIGHT (8) NINE (9) TEN (10) ELEVEN (11) TWELVE (12) AND THIRTEEN (13) OF SECTION TWENTY (20) TOWNSHIP TWENTY SIX (26) SOUTH RANGE SIX (6) WEST OF THE WILLAMETTE MERIDIAN IN SAID COUNTY OF DOUGLAS, AND WHEREAS, SAID PLAT WAS DULY APPROVED BY THE COUNTY SURVEYOR AND THE COUNTY ASSESSOR AND THE COUNTY COURT OF SAID COUNTY OF DOUGLAS; AND WHEREAS, SOME QUESTION HAS ARISEN AS TO THE SUFFICIENCY OF SAID PLAT BECAUSE OF THE FACT THAT IT WAS NOT ACCOMPANIED BY A DEED OF DEDICATION AND WAS NOT ACKNOWLEDGED BY THE OWNER OF SAID LANDS; AND

WHEREAS, THE SAID J. H. BOOTH AND HIS WIFE CATHERINE A. BOOTH, HAVE CONVEYED, DIVERS PORTIONS OF SAID LAND BY REFERENCE TO SAID PLAT.  
NOW THEREFOR, WE, THE SAID J. H. BOOTH AND KATE A. BOOTH, HIS WIFE, FOR THE PURPOSE OF CONFIRMING SAID PLAT AND IN CONSIDERATION OF THE PREMISES DO HEREBY DECLARE THE SAID PLAT SO FILED AS AFORESAID, AND RECORDED AT PAGE 58 OF BOOK 1 OF THE RECORDS OF PLATS OF SAID COUNTY OF DOUGLAS, TO BE THE TRUE AND CORRECT PLAT OF SAID ROSEBURG HOME ORCHARD TRACTS, AND WE DO HEREBY EXPRESSLY RATIFY AND CONFIRM ALL DEEDS AT ANY TIME HERETOFORE MADE BY US IN WHICH REFERENCE IS MADE TO SAID PLAT, AND WE DO HEREBY DEDICATE UNTO THE PUBLIC USE ALL ROADS, HIGHWAYS, AND ALLEYS AS INDICATED UPON THE AFORESAID PLAT.  
IN WITNESS WHEREOF WE HAVE HEREUNTO SET OUR HANDS AND SEALS THIS 7TH DAY OF JANUARY 1913.  
EXECUTED IN PRESENCE OF  
F. P. CLEMENS  
G. V. WIMBERLY

(SGD) J. H. BOOTH (SEAL)  
(SGD) CATHERINE A. BOOTH (SEAL)

STATE OF OREGON }  
COUNTY OF DOUGLAS } SS


THIS IS TO CERTIFY THAT ON THIS 7TH DAY OF JANUARY 1913 BEFORE ME THE UNDERSIGNED NOTARY PUBLIC IN AND FOR SAID COUNTY AND STATE, PERSONALLY APPEARED J. H. BOOTH AND CATHERINE A. BOOTH HIS WIFE, TO ME KNOWN TO BE THE IDENTICAL PERSONS DESCRIBED IN AND WHO EXECUTED THE FOREGOING INSTRUMENT AND THEY ACKNOWLEDGED TO ME THAT THEY EXECUTED THE SAME FREELY AND VOLUNTARILY AND FURTHER ACKNOWLEDGED TO ME THAT THEY EXECUTED THE PLAT OF ROSEBURG HOME ORCHARD TRACTS REFERRED TO IN THE FOREGOING INSTRUMENT.

IN TESTIMONY WHEREOF I HAVE HEREUNTO SET MY HAND AND OFFICIAL SEAL THE DAY AND YEAR LAST ABOVE WRITTEN.

(SEAL) (SGD) G. V. WIMBERLY,  
NOTARY PUBLIC FOR OREGON

FILED FOR RECORD JANUARY 11TH 1913, E. H. LENOX, COUNTY CLERK; BY: RITA K. COBB, DEPUTY (SGD)

NOTE: THE DEDICATION SHOWN HEREON IS A COPY THEREOF AS SHOWN IN VOL 71, PAGE 545, DEED RECORDS OF DOUGLAS COUNTY OREGON.

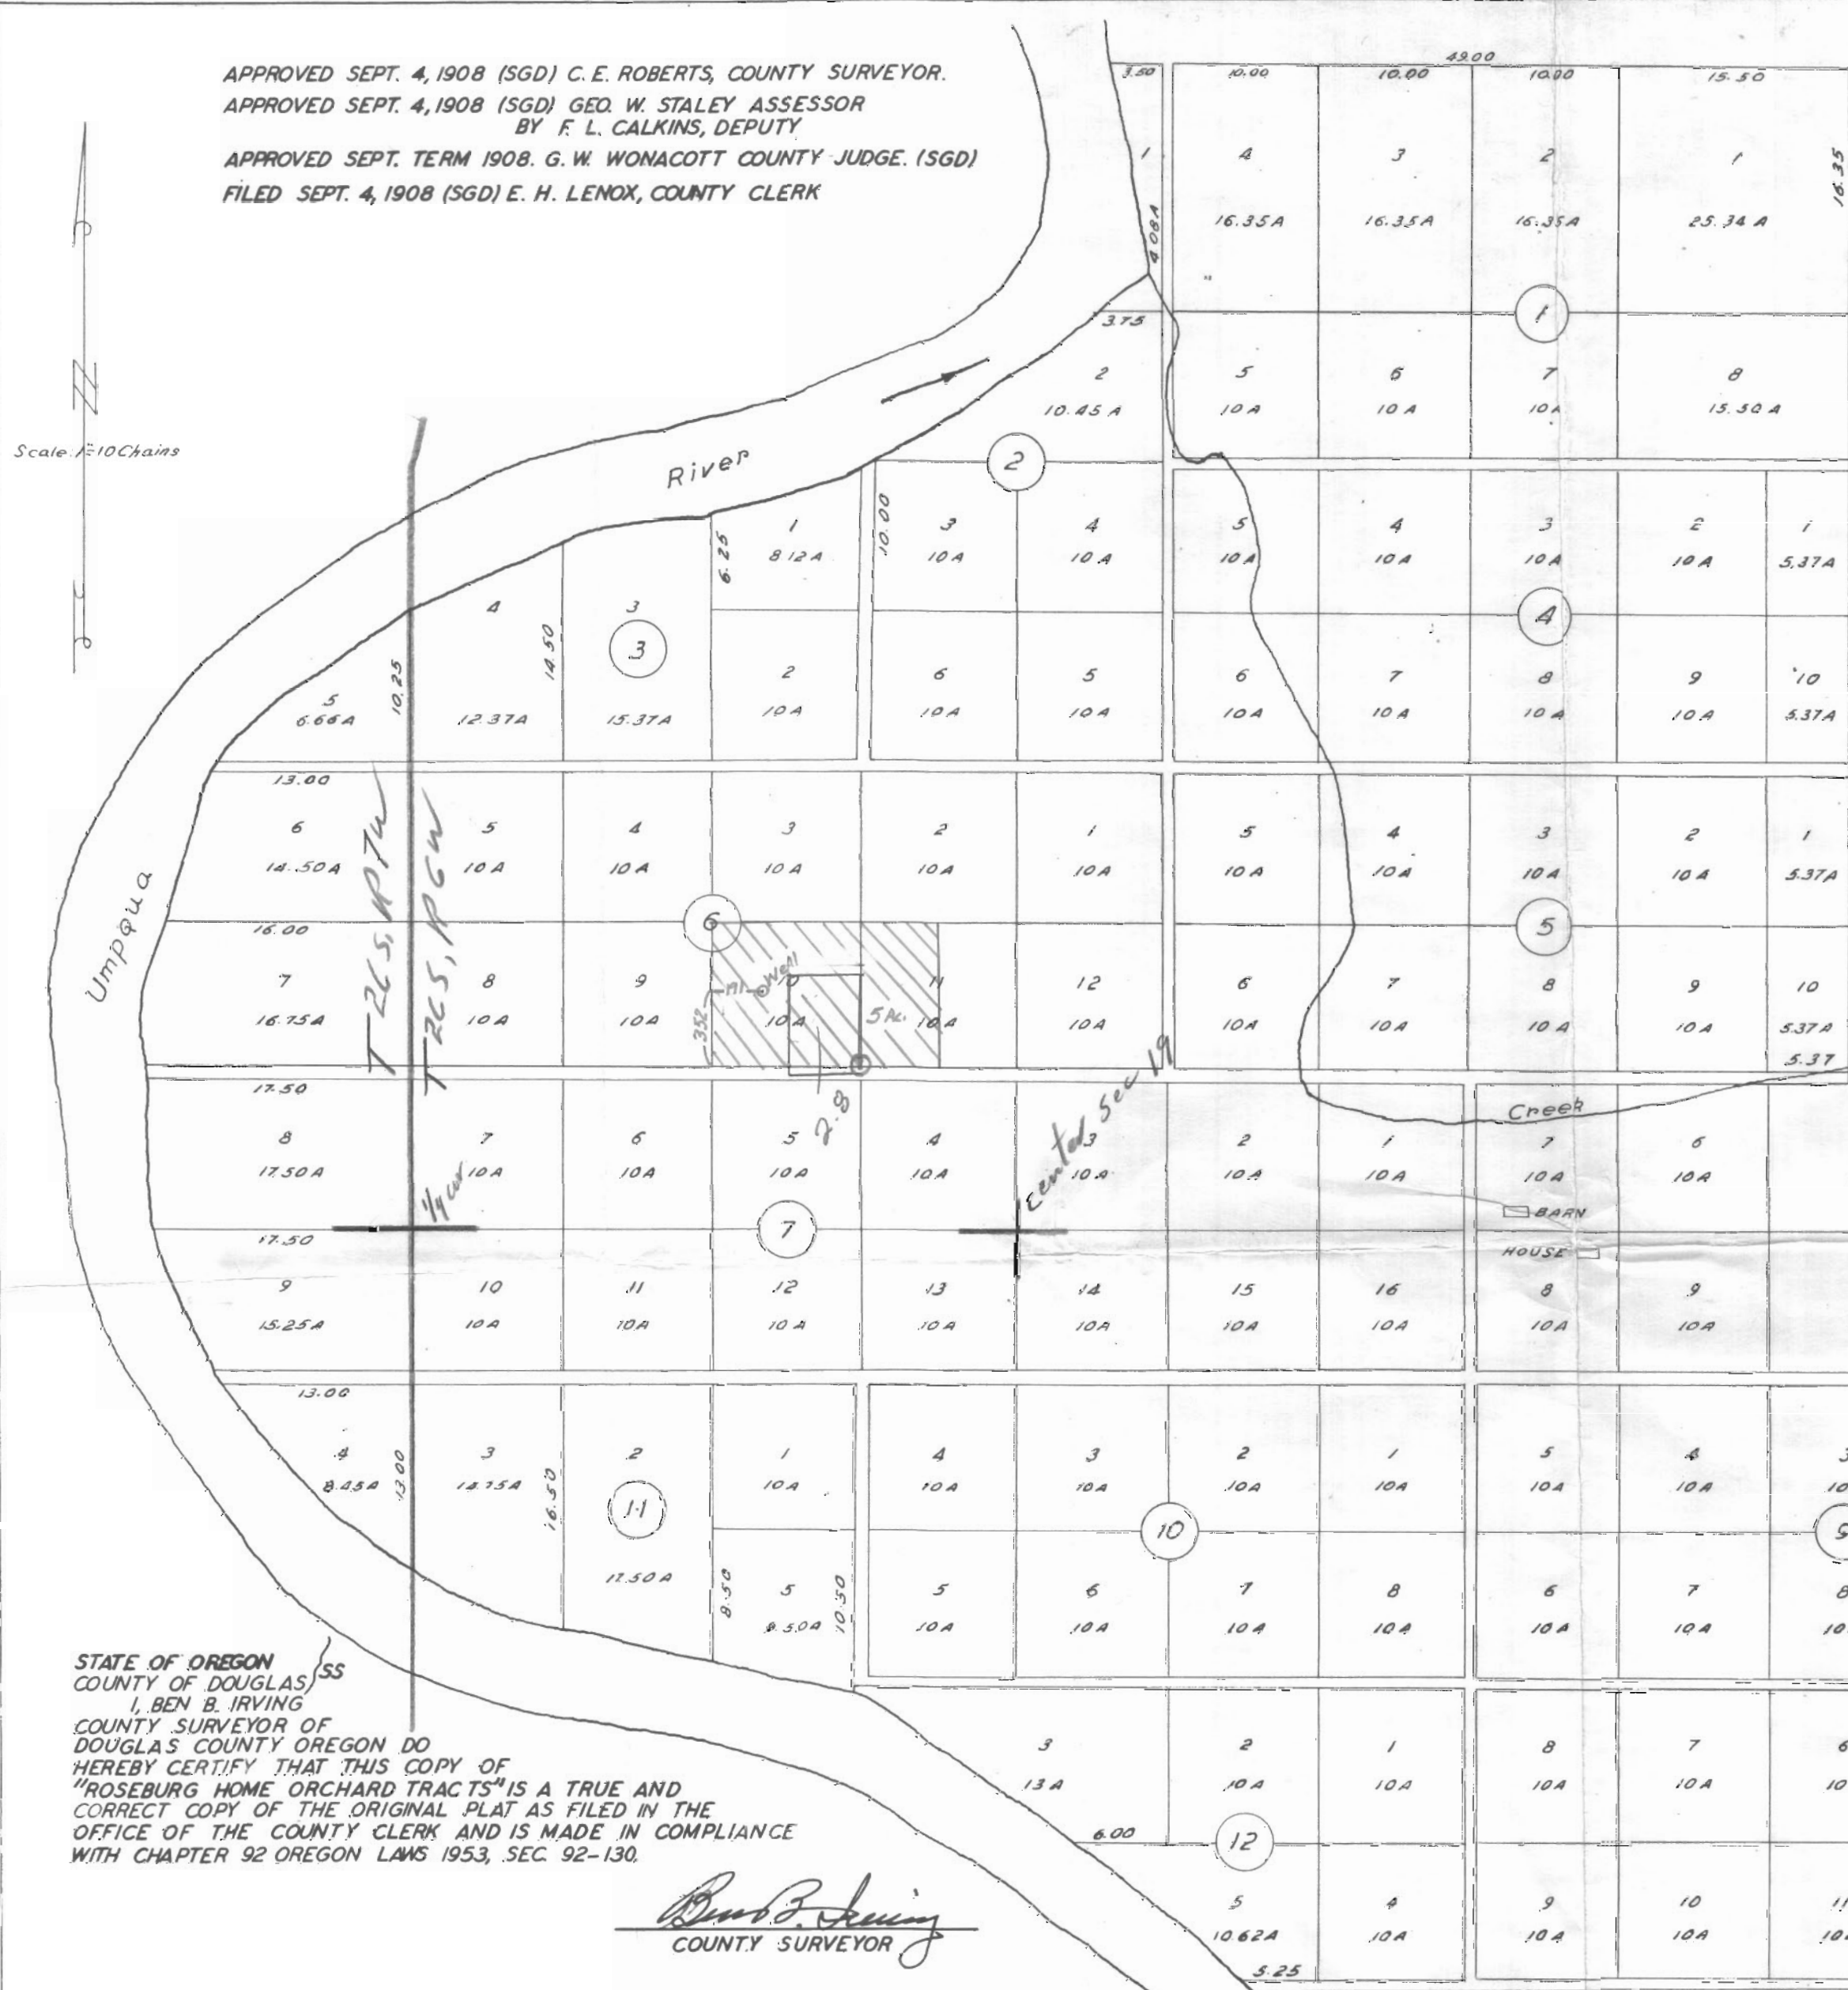

STATE OF OREGON }  
COUNTY OF DOUGLAS } SS  
I, BEN B. IRVING  
COUNTY SURVEYOR OF  
DOUGLAS COUNTY OREGON DO  
HEREBY CERTIFY THAT THIS COPY OF  
"ROSEBURG HOME ORCHARD TRACTS" IS A TRUE AND  
CORRECT COPY OF THE ORIGINAL PLAT AS FILED IN THE  
OFFICE OF THE COUNTY CLERK AND IS MADE IN COMPLIANCE  
WITH CHAPTER 92 OREGON LAWS 1953, SEC. 92-130.

*Ben B. Irving*  
COUNTY SURVEYOR

SUBSCRIBED AND SWORN TO BEFORE ME THIS 26 DAY OF January 1955.

*Chas. Doerner*  
COUNTY CLERK

STATE OF OREGON }  
COUNTY OF DOUGLAS } SS

I, CHAS. DOERNER, COUNTY CLERK OF DOUGLAS COUNTY OREGON DO HEREBY CERTIFY THAT THE FOREGOING COPY OF PLAT HAS BEEN BY ME COMPARED WITH THE ORIGINAL THEREOF THAT IT IS A TRUE AND CORRECT COPY THEREFROM AND OF THE WHOLE THEREOF AS THE SAME APPEARS ON FILE IN MY OFFICE AND CUSTODY.

WITNESS MY HAND AND OFFICIAL SEAL THIS 26 DAY OF January 1955.

*Chas. Doerner*  
COUNTY CLERK

RECORDED  
AUG 15 1963  
STATE ENGINEER  
SALEM, OREGON

RECEIVED  
SEP 4 1963  
STATE ENGINEER  
SALEM, OREGON