


T26S, R6W, WM

SCALE 1" = 1320'

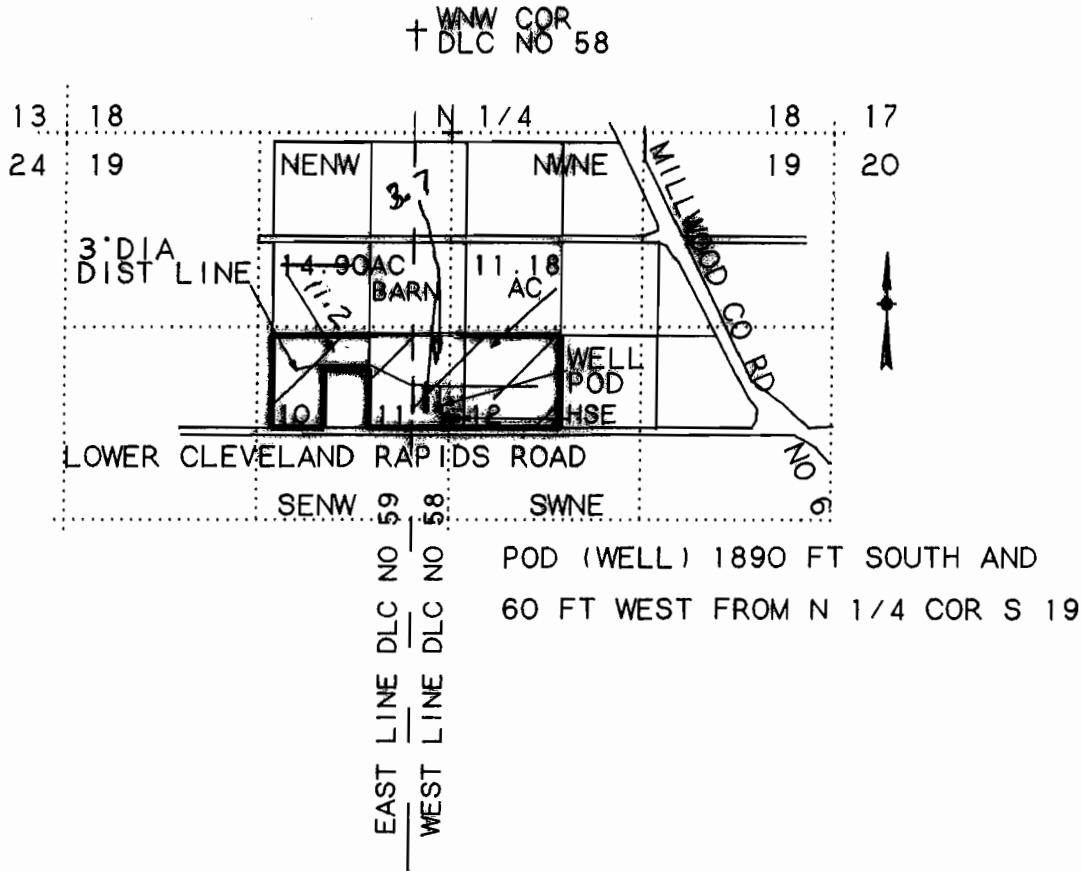

FINAL PROOF SURVEY


UNDER

Application No. G-12235 Permit No. G-11222

IN NAME OF

RAYMOND L or KAYE L LEHNE

Surveyed September 10, 1991 by M E Farr

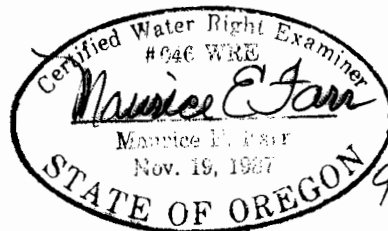

9-91

Raymond L. Lehne