


# T.3N.R.28E.W.M.

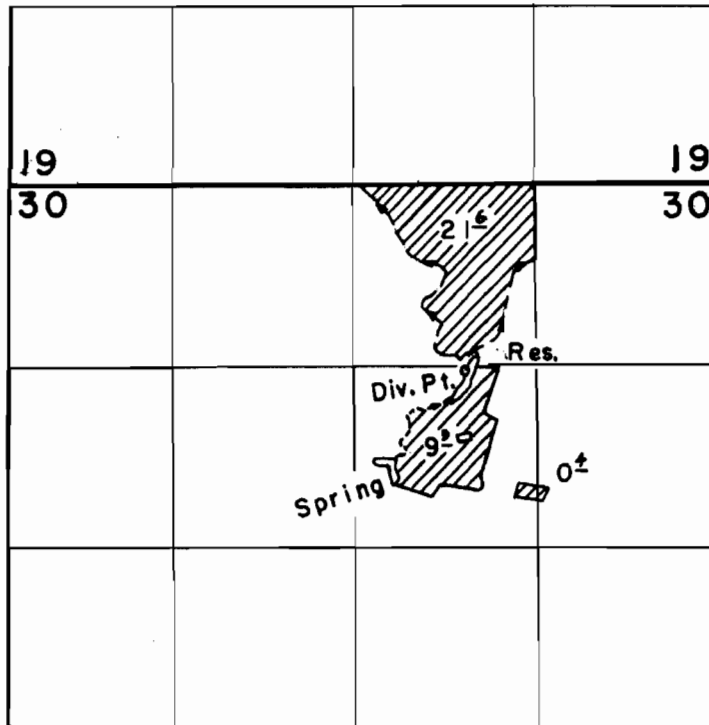

## FINAL PROOF SURVEY UNDER

Application No. 33223... Permit No. 26265.  
IN NAME OF

.....Gaylord M. Madison.....

Surveyed Aug. 21, 1964, by C. J. Gardner.....